

15. 12. 11  
8. 2. 11  
3. 2. 11  
20. 2. 11  
31. 5. 11  
14. 6. 11  
29. 6. 11  
14. 7. 11  
16. 10. 11

— No 303, T 5.5. —

— Longitudinal Section. —


- Dimensions 495'0" x 60'6" x 39'6" to Shell Per Dk -

— To Class 100 A.I. Lloyds —

— Scale  $\frac{1}{8}'' = \text{ONE Foot.}$  —

Sketch showing arrangement of Superstructures  
to be submitted. -

Deck plans to be submitted.

 

SPECIAL PLAN SHEWING WEBS + THRO BEAMS + GIRDERS  
IN MACHINERY SPACE WILL BE SUBMITTED LATER.

GIRDERS 20" DEEP + ABOVE TO HAVE BRACKET SUPPORT AT EACH TRANSVERSE + TWO INTERMEDIATE BRKTS

REVERSES  $3 \times 3\frac{1}{2} \times .40$  TO TOP OF W.T. SLAT.



Workman Clark

N<sup>o</sup> 303

Swain Man

Profile


---

S. S. Vestris

Bel. 81 20.



RETAIN

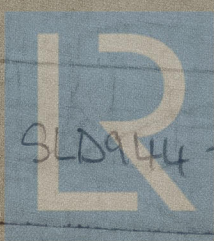

© 2021

SLD944-0083 Lloyd's Register  
Foundation