
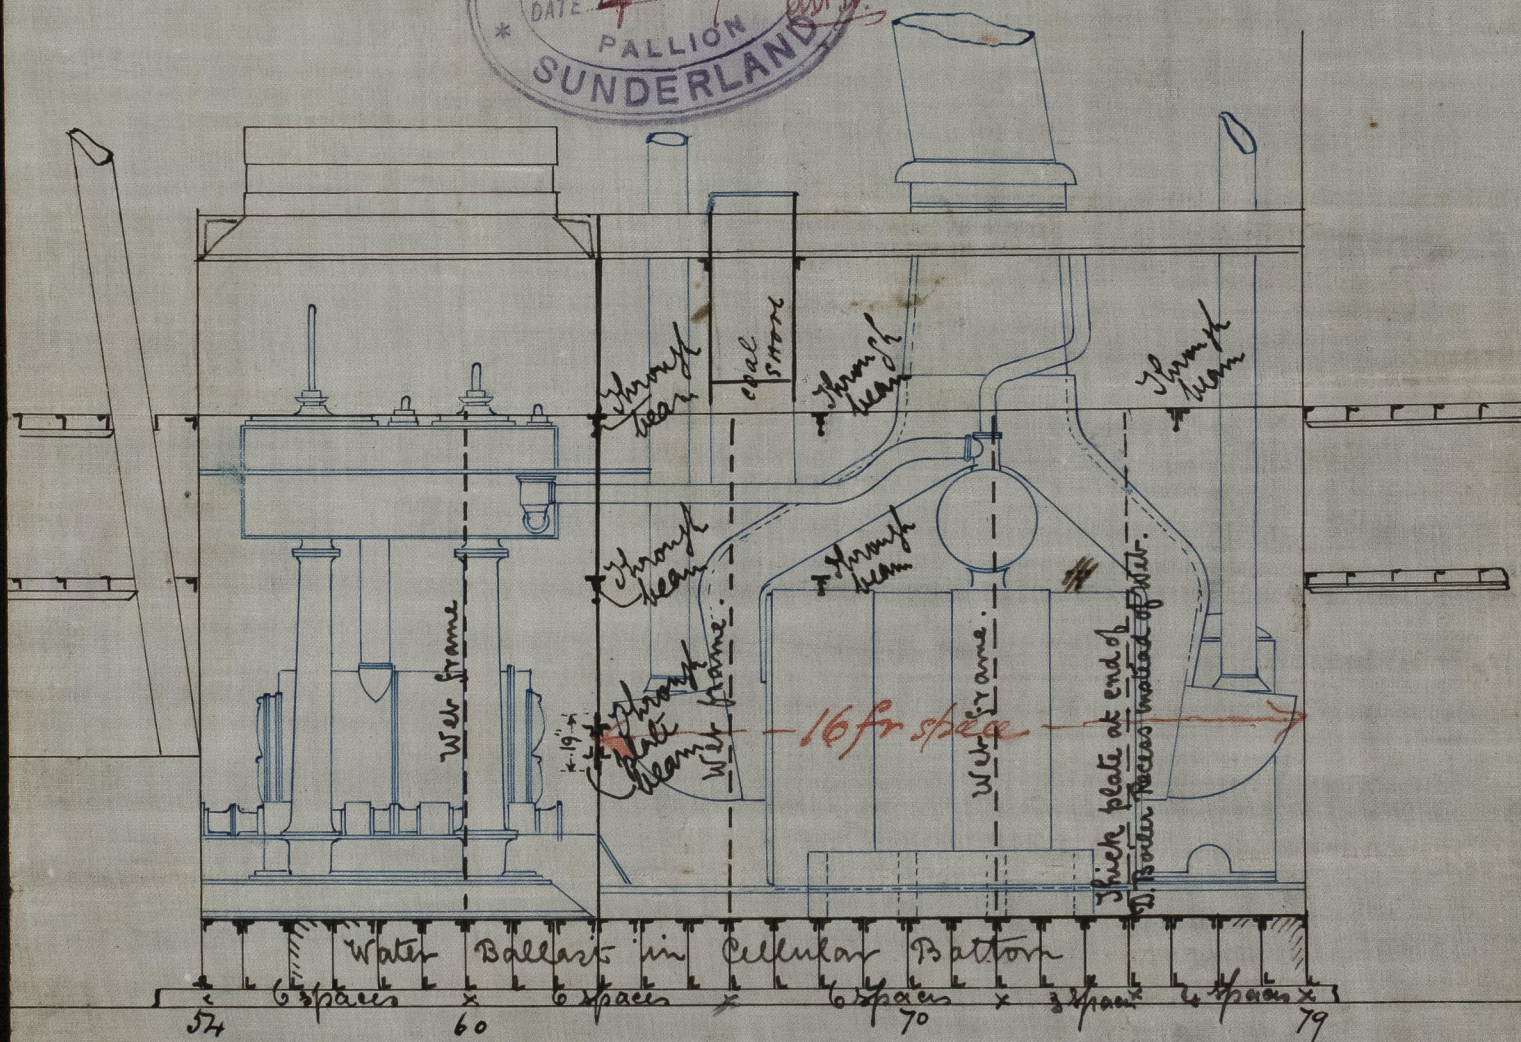


1st NCV. 82.
Ltr. to Sunderland
8/11/82.

Iron 75. Abington Sld report No. 13029

No. 143

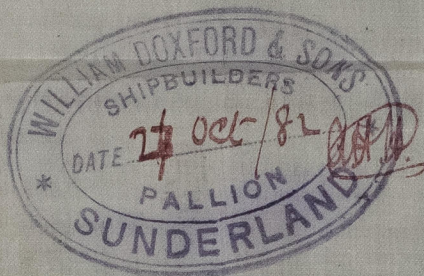

J. H. C.
7/11/82

SLA944-0143