



Iron of Abington Sld. report No 13029



Lt. K. Lunderland
8/11/82.

S. S. No 143.

Section through Boiler Space

Scale $\frac{3}{8}'' = 1$ Foot.

Section on Frame 63

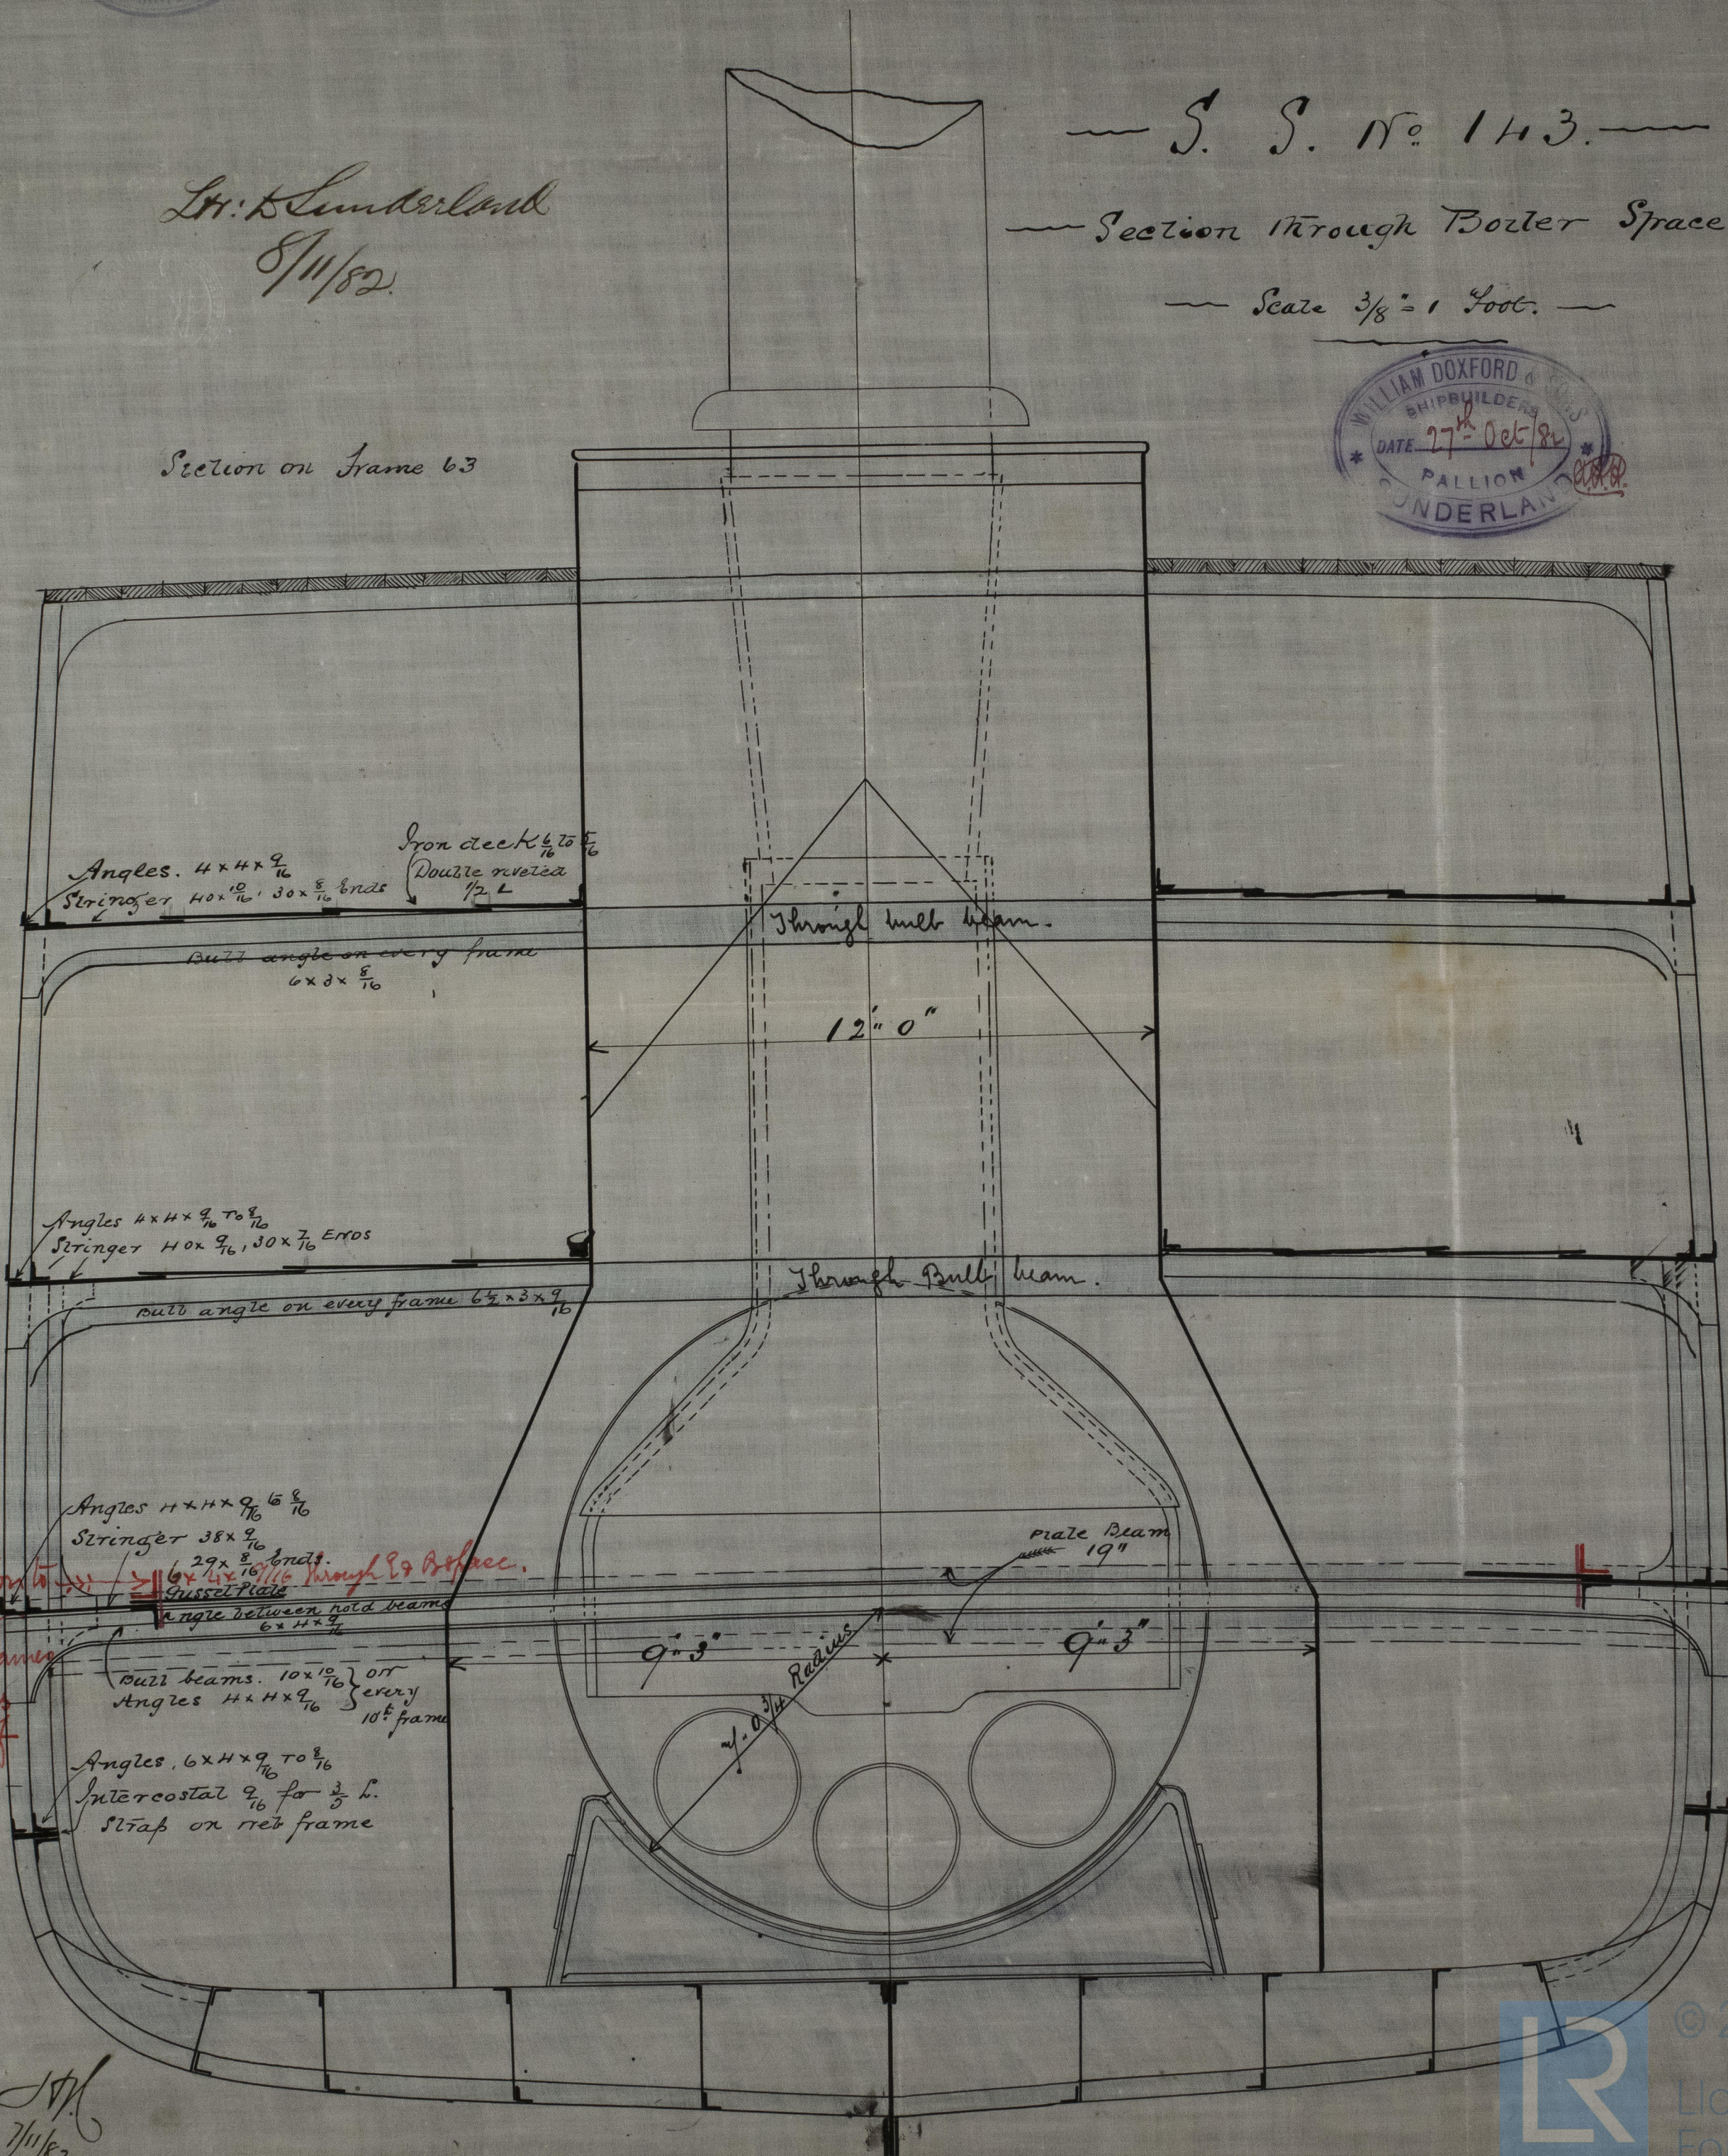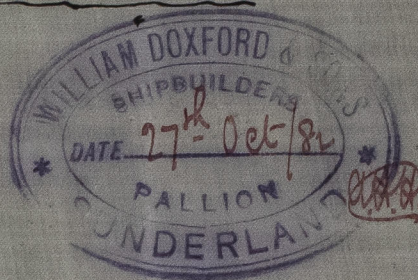

Proposed addition to compensate for spacing of web frames which are 6 spaces apart instead of five.

J.H.
7/11/82

SLD944-0145



© 2021
Lloyd's Register
Foundation