No. 667.

S. S. 61 Iron s/s. Permanent Sld. report No. 13.111

Scale 1/2" = 1 foot

Spar deck Rule

Length 248.5
Breadth 35.80
Depth 18.75

Depth to length 13.25
Breadth to length 6.90

This arrangement carried out in ship. J.S.

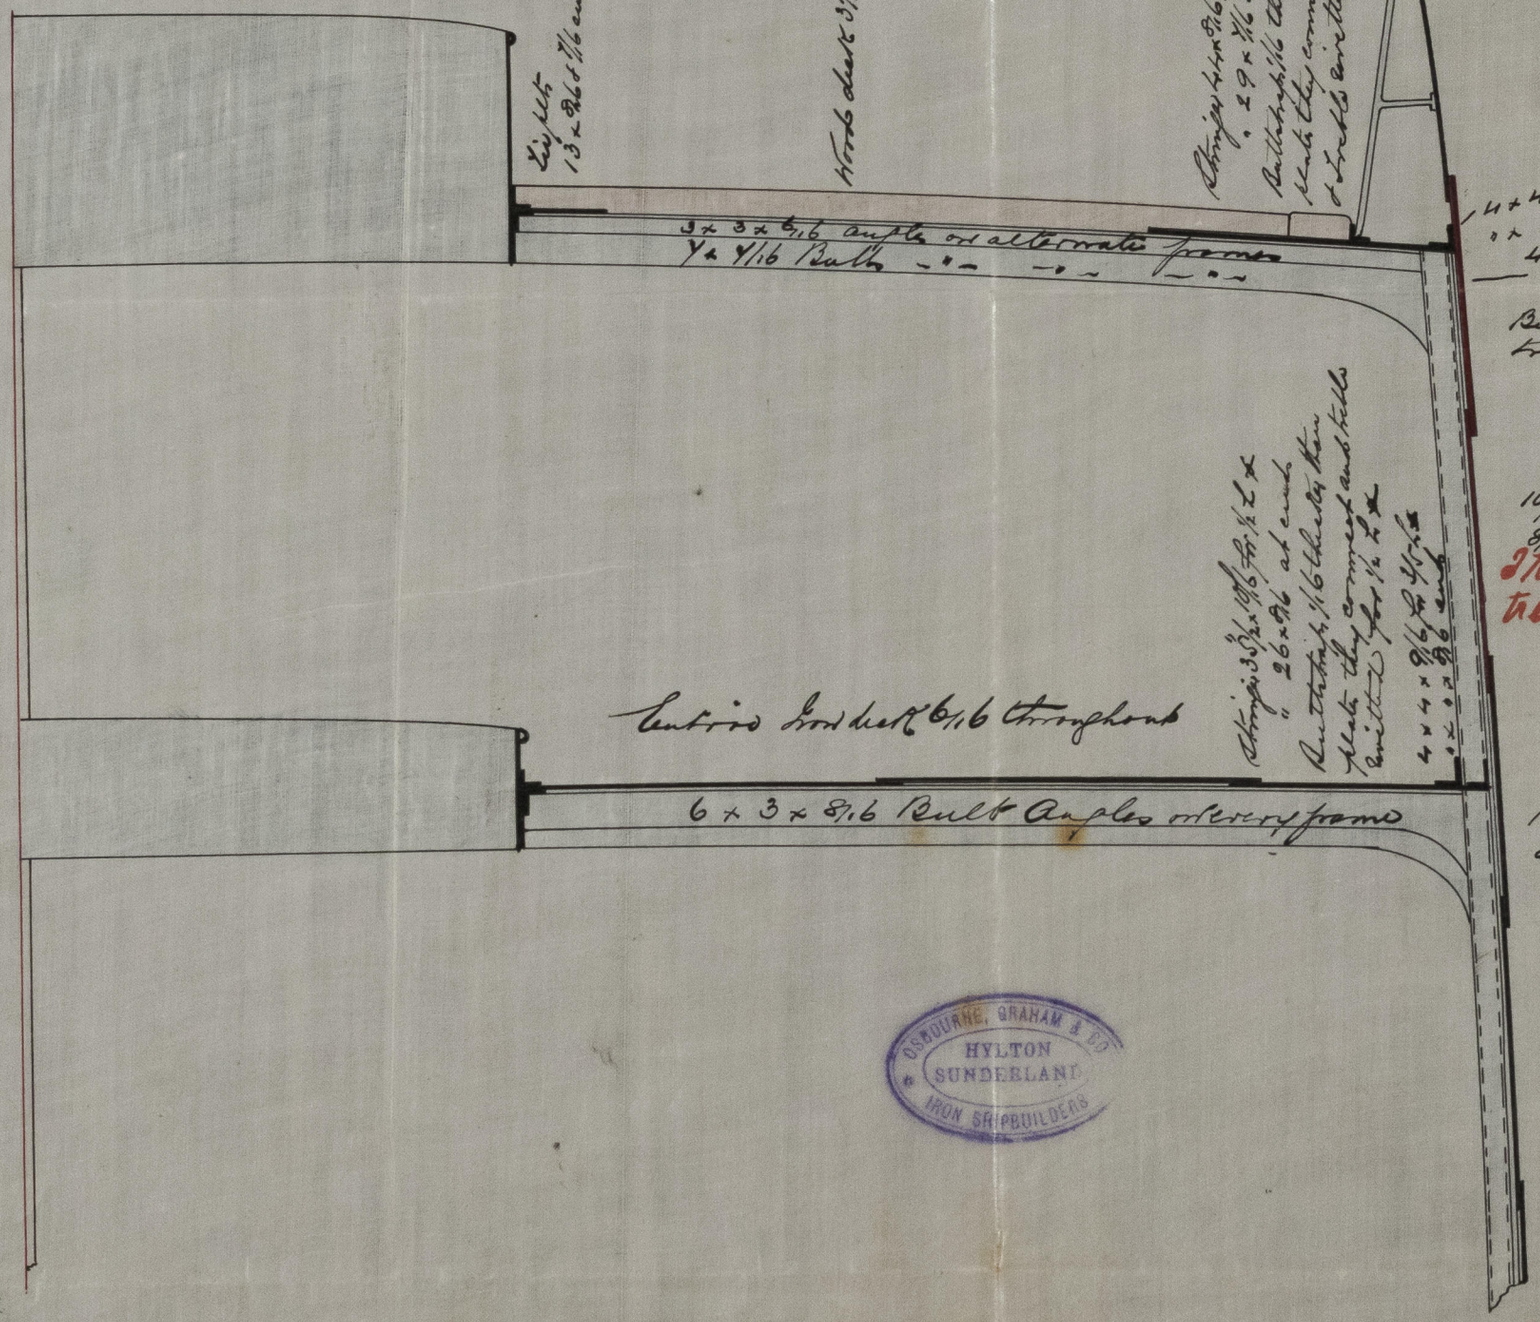

OSBOURNE, GRAHAM & CO. HYLTON SUNDERLAND IRON SHIPBUILDERS

J. S. 11/9/82

September 7th 1882

SLD945-0109
© 2021 Lloyd's Register Foundation