


SCREW STEAMERS.

Yard No 197 s/s. "Robina" Sld report No 13,292

"No 193.5.7.8 & 201.203"


METAL PIPES.

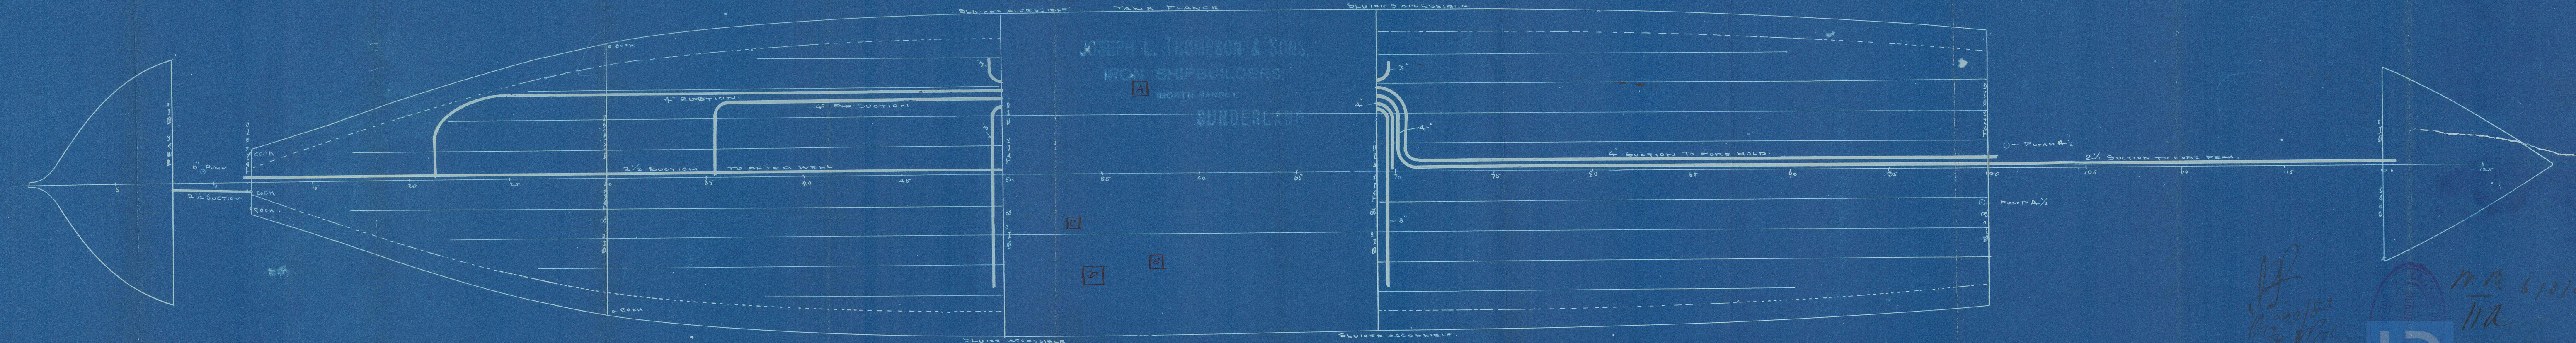

JOSEPH L. THOMPSON & SONS  
IRON SHIPBUILDERS  
SUNDERLAND

A. Main Engineer & Head drawing  
B. " " " " " "  
C. " " " " " "  
D. " " " " " "

*Handwritten notes:*  
Mr. B. 6/13/83  
11A  
01222/83  
79 H.P.C.

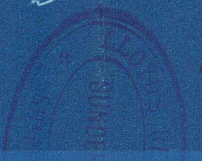

SLD947-0134  
Foundation



1770 - Ballant

193  
Badast Sucklin  
Moyse

SLD947-0134

0134

*refused*



© 2021

Lloyd's Register  
Foundation