

# Lloyd's Register of British and Foreign Shipping.

(Received in the London Office.)



F.

No. 167

## REPORT ON SHIP FORGINGS.

Sir,

I beg leave to report that the undermentioned Forgings, manufactured by Messrs of Bambridge & Co of Pallion for the Vessel No. 194, being built by Messrs of L Thompson Sons of Sunderland have been inspected by me in course of being forged and smithed, and found to be, so far as can be seen, sound and efficient.

D. P.  
6/10/83

Mark on Forging.

Lloyd's  
No. 167  
6/83 9/83  
No. 167

I am, Sir,

Your Obedient Servant,


H. Cameron.

The Secretary,  
London.

Sunderland.

	STERN FRAME.	RUDDER FRAME.	STEM.
Material*	Scrap Iron	Scrap Iron	Scrap Iron
How made	Forged	Forged	Forged
Dimensions	8 1/2" x 5"	6 1/4" x 3 1/4"	8 1/2" x 2 1/2"
Progress on Inspection	Forging & smithing	Forging & smithing	Forging & smithing
Dates when Inspected	May 16-24 June 5-11-20-25 <sup>th</sup>	Aug 13-17-23-25-31 Sept 8-14 <sup>th</sup>	June 5-11-25 <sup>th</sup>

SKETCHES OF FRAMES SHEWING POSITION AND DESCRIPTION OF WELDS.

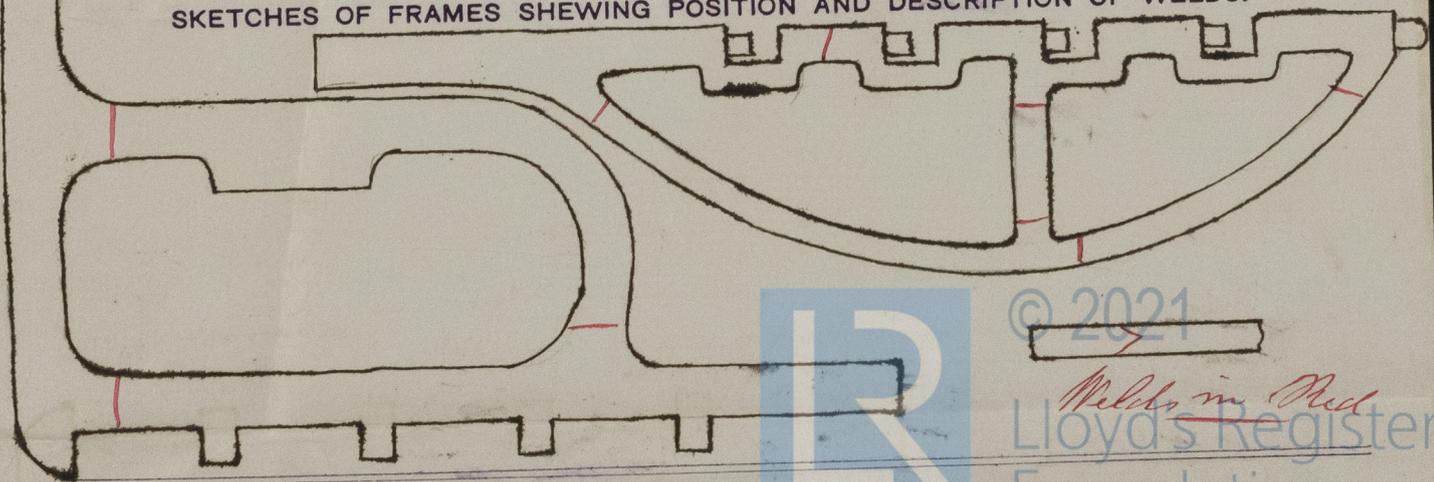

\* If of iron, state whether scrap or puddled iron.

