

Dr. to Ld:
1/2/83



Iron & Steel Western Star Sld. report No. 13292

S.S. No. 144

Scale $\frac{1}{8}$ in = one foot.



S. P. AUSTIN & SON
25/1/83
IRON & STEEL SHIPBUILDERS
AND
REPAIRERS
SUNDERLAND

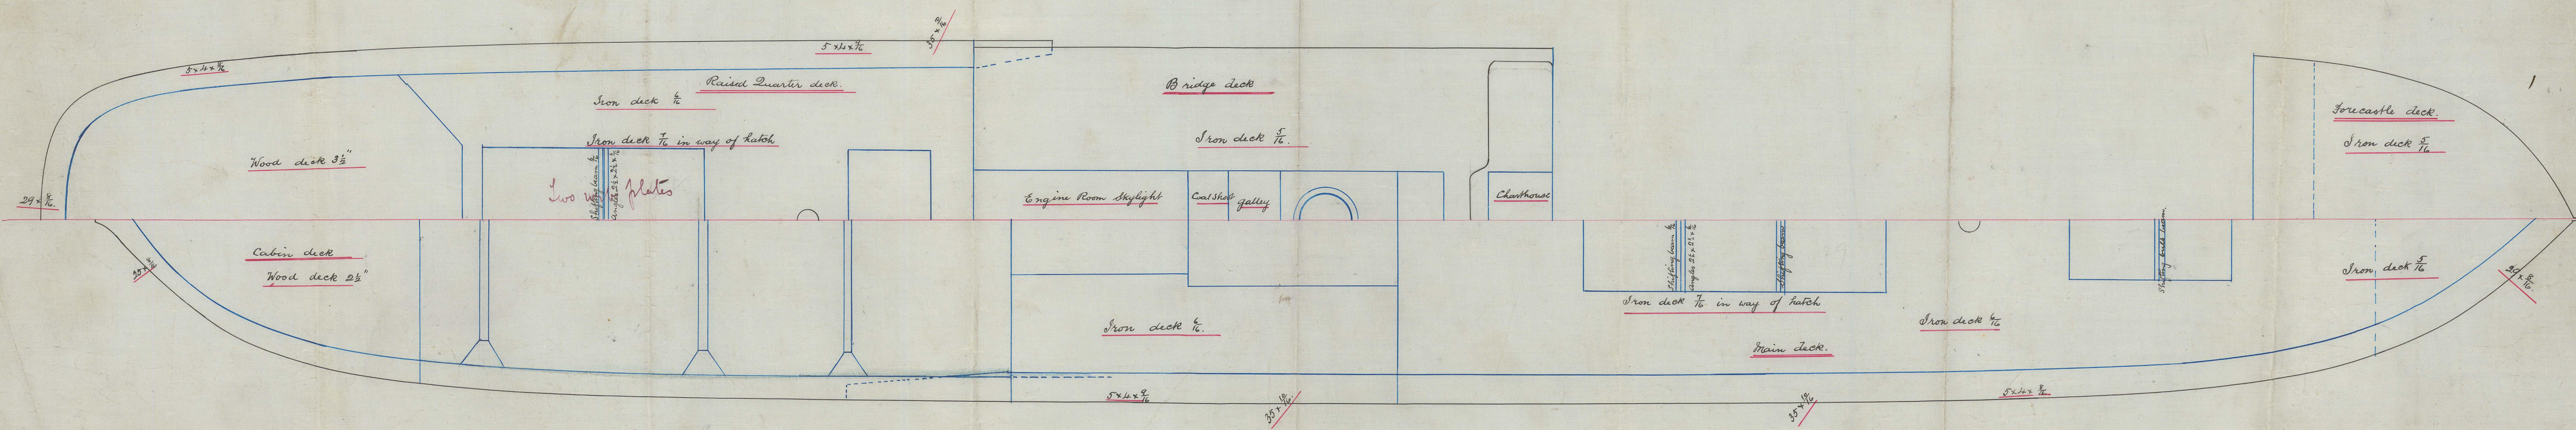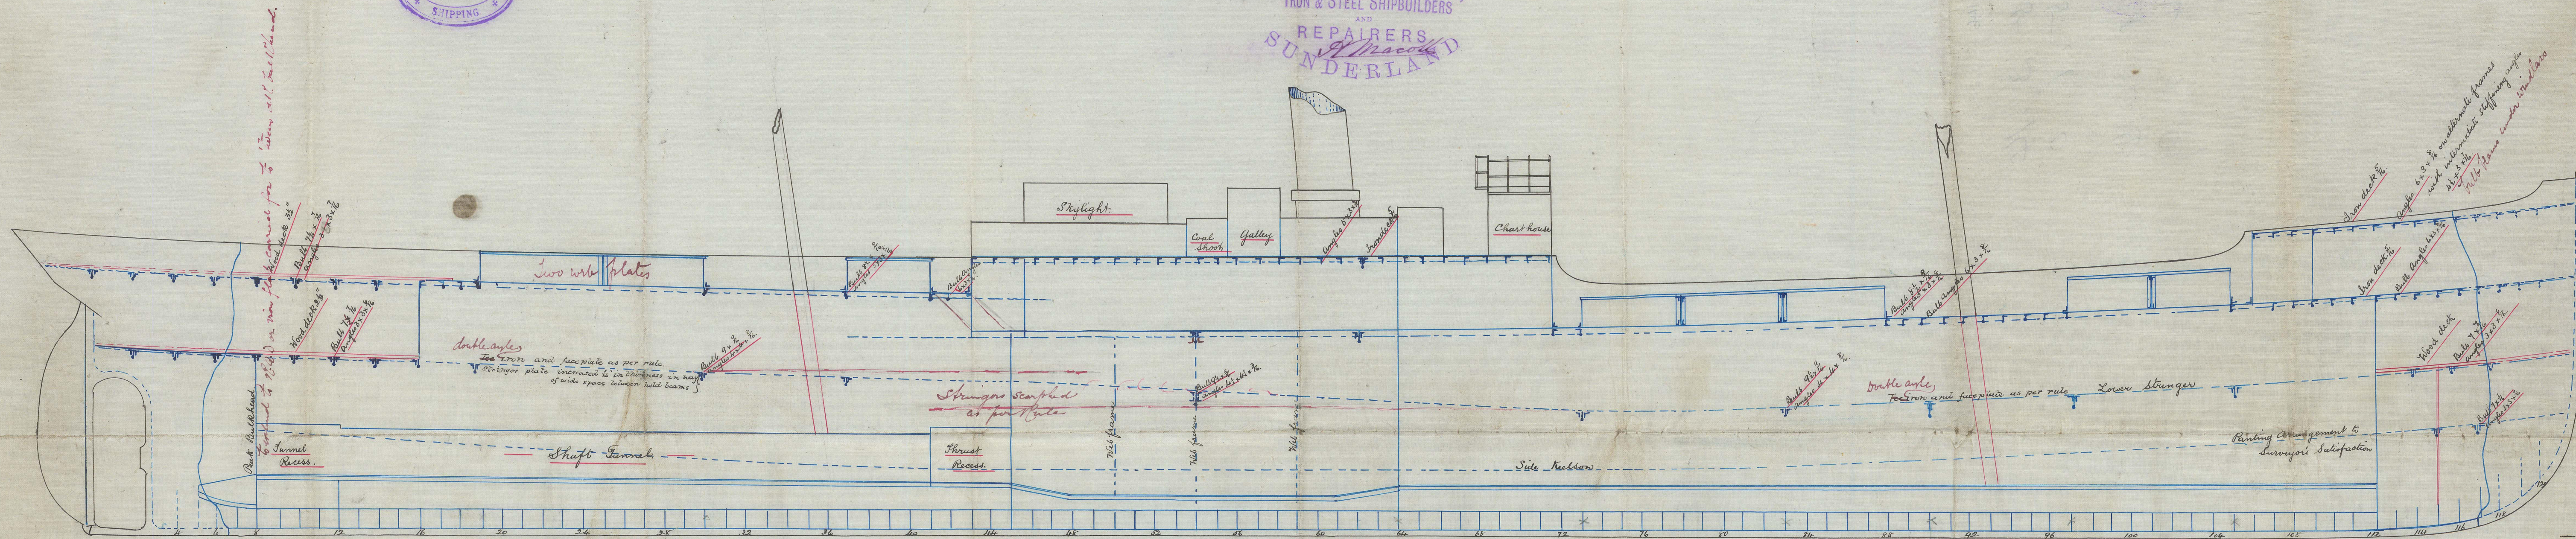

J.H.
31/1/83

SLD947-0146

№ 12582 { 25 . 3 . 14
5 . 1 . 0

№ 12352 { 21 . 2 . 14
4 . 3 . 0



© 2021

Lloyd's Register
Foundation