

Lloyd's Register of British and Foreign Shipping.

(Received in the London Office, 25 OCT 83.)

F.

No. 371

REPORT ON SHIP FORGINGS.

Sir,

I beg leave to report that the undermentioned Forgings, manufactured by Messrs Peay & Usher of Hylton for the Vessel No. 144, being built by Messrs S P Austin & Sons of Sunderland have been inspected by me in course of being forged and smithed, and found to be, so far as can be seen, sound and efficient.

Mark on Forging.

Lloyd's

No. 371

7/82

H.C.

10/83

I am, Sir,

Your Obedient Servant,

H Cameron.


The Secretary,
London.

Sunderland.

D.G.
26/10/83

	STERN FRAME.	RUDDER FRAME.	STEM.
Material*	<u>Scrap Iron</u>	<u>Scrap Iron</u>	<u>Scrap Iron</u>
How made	<u>Forged</u>	<u>Forged</u>	<u>Forged</u>
Dimensions	<u>8 1/2" x 5"</u>	<u>6 1/4" x 3 1/4"</u>	<u>8 1/2" x 2 1/2"</u>
Progress on Inspection	<u>Forging & smithing</u>	<u>Forging & smithing</u>	<u>Finished</u>
Dates when Inspected	<u>May 24-30 Jun 6-11. 25</u> <u>July 10th</u>	<u>Aug 23-25-31 Sept 5-13</u> <u>Oct 4th</u>	<u>July 10th</u>

SKETCHES OF FRAMES SHEWING POSITION AND DESCRIPTION OF WELDS.

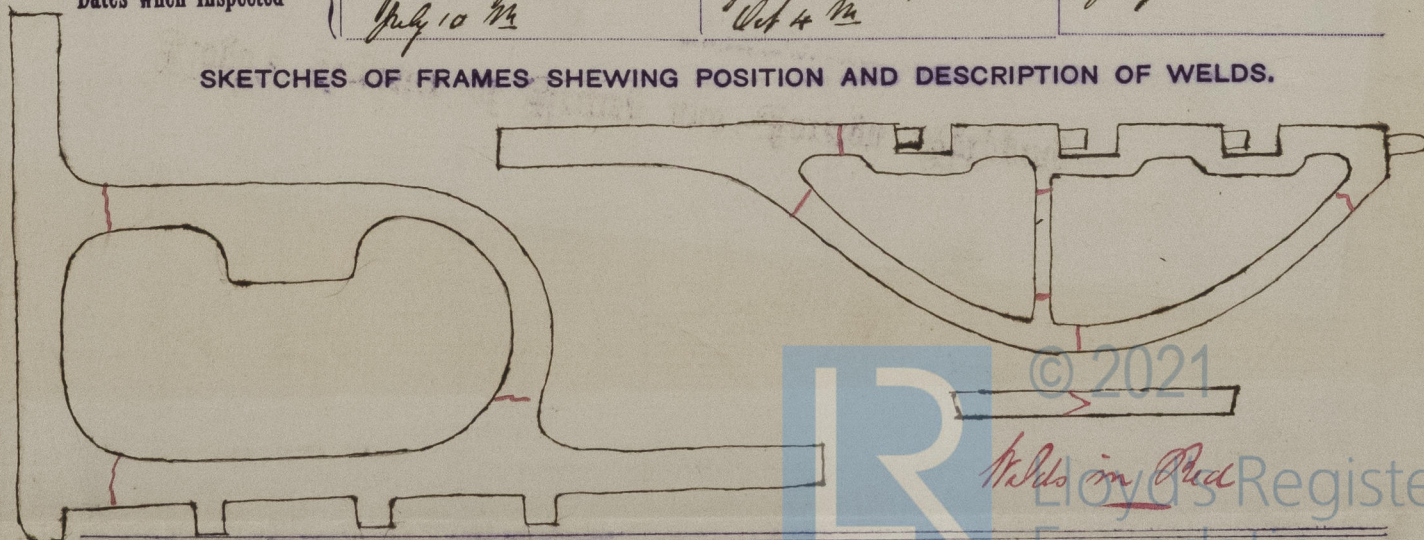

* If of iron, state whether scrap or puddled iron.