


S. P. AUSTIN & SON
IRON & STEEL SHIPBUILDERS
AND
REPAIRERS
SUN

Scale $\frac{1}{8}'' = 1 \text{ Foot}$

See amended Profile

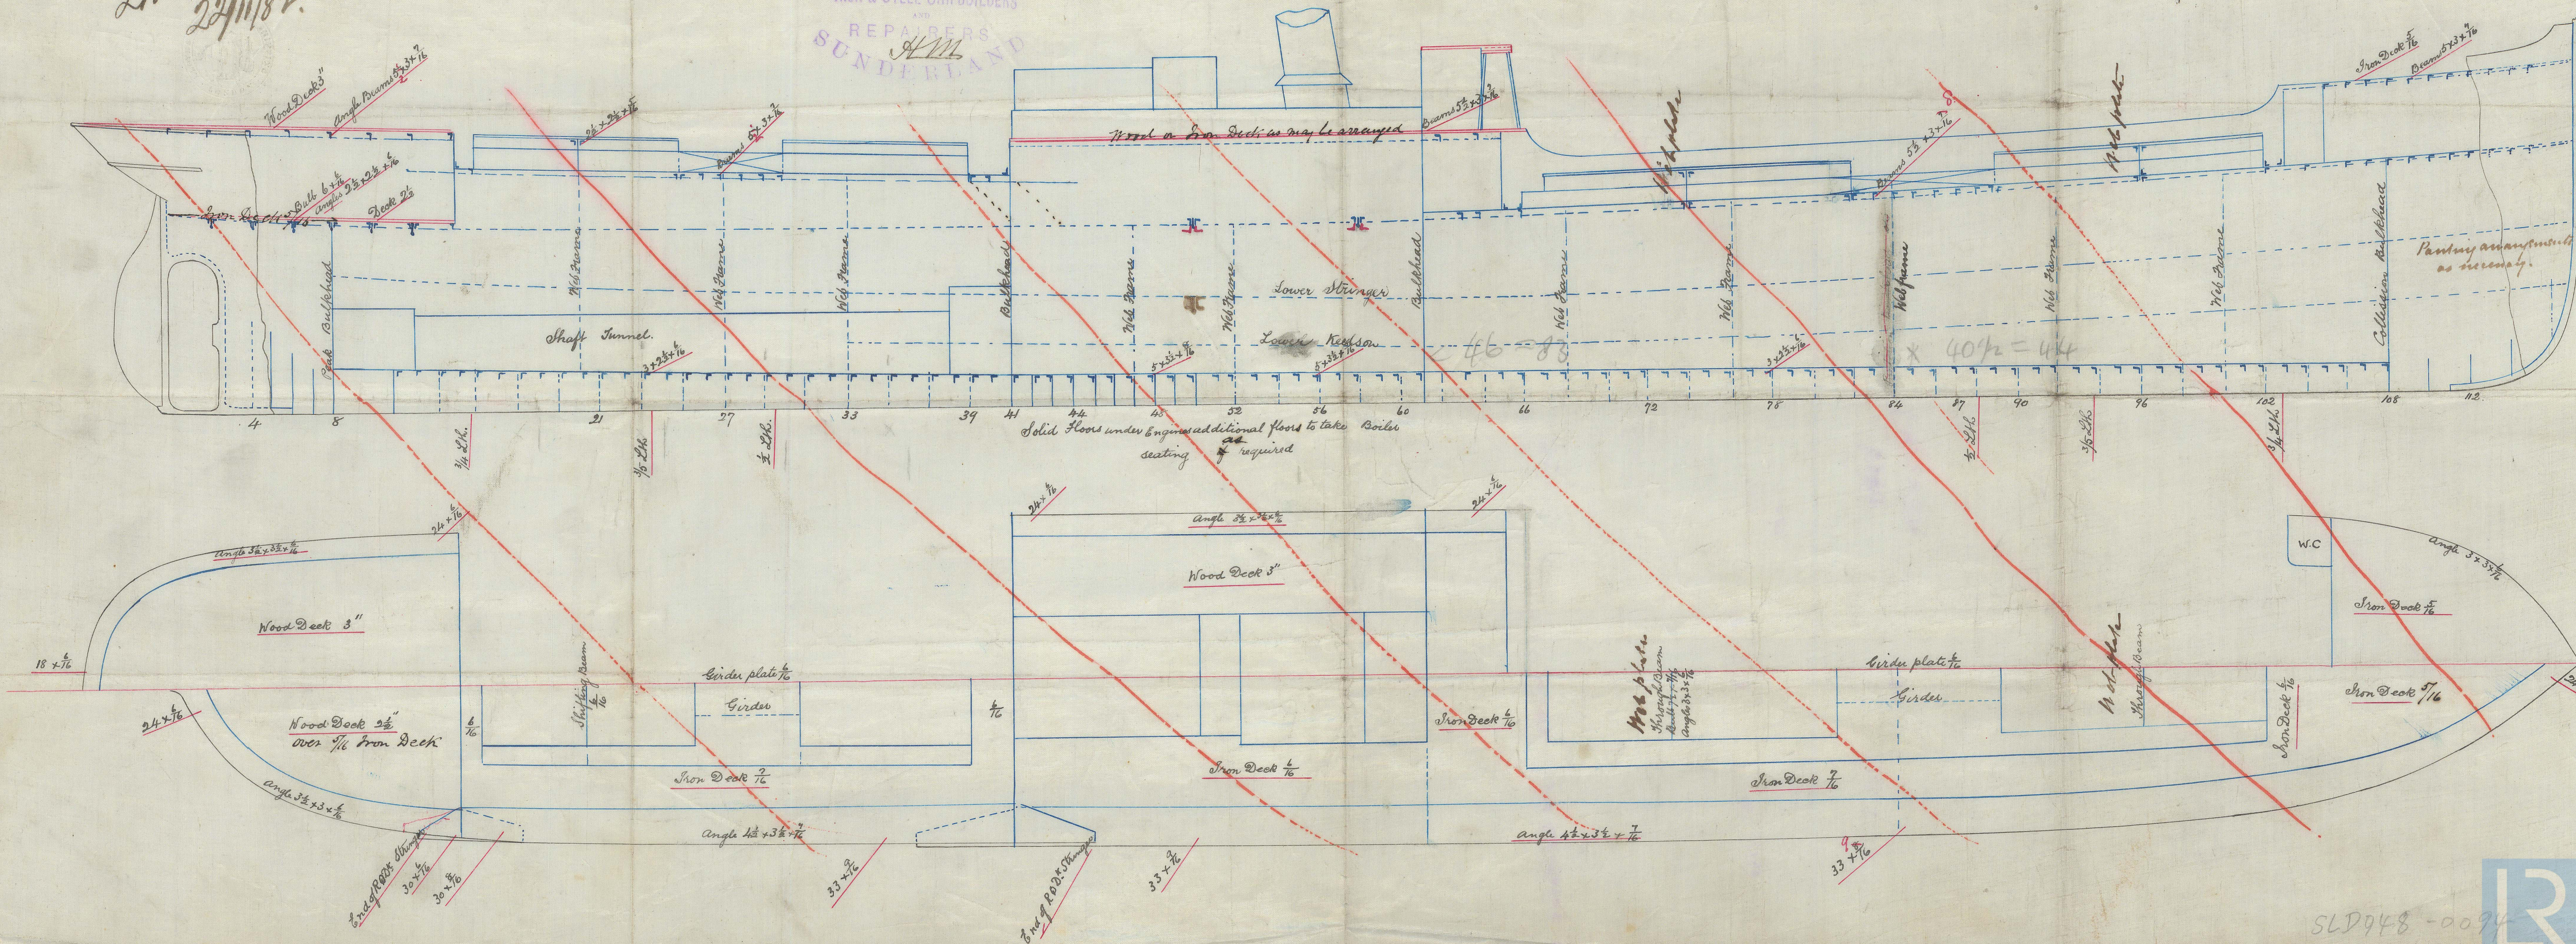

Pl. 13. 17/11/02