

Austin & Son Ltd. 145 Dumfries St. Rep. No. 13,350

Lloyd's Register of British and Foreign Shipping.

(Received in the London Office,)



F.

No. *75*


REPORT ON SHIP FORGINGS.

Sir,

I beg leave to report that the undermentioned Forgings, manufactured by *Messrs The North Quay Coy. of Sunderland.* for the Vessel No. *145*, being built by *Messrs Austin & Sons* of *Sunderland* have been inspected by me in course of being forged and smithed, and found to be, so far as can be seen, *sound and efficient.*

D. J. 6/10/83

Mark on Forging.

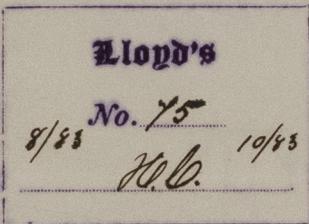

I am, Sir,

Your Obedient Servant,



H. Cameron.

The Secretary,
London.

Sunderland.

	STERN FRAME.	RUDDER FRAME.	STEM.
Material*	<i>Scrap Iron</i>	<i>Scrap Iron</i>	<i>Scrap Iron</i>
How made	<i>Forged</i>	<i>Forged</i>	<i>Forged</i>
Dimensions	<i>7 x 14 3/4"</i>	<i>5 x 3"</i>	<i>4 x 2 3/4"</i>
Progress on Inspection	<i>Forging & Smithing</i>	<i>Forging & Smithing</i>	<i>Forging</i>
Dates when Inspected	<i>June 2-16-25-30 July 5 16 Aug 9-23</i>	<i>Aug 9-23 Sept 5-17 24 Oct 1st</i>	<i>Aug 9-23</i>

SKETCHES OF FRAMES SHEWING POSITION AND DESCRIPTION OF WELDS.

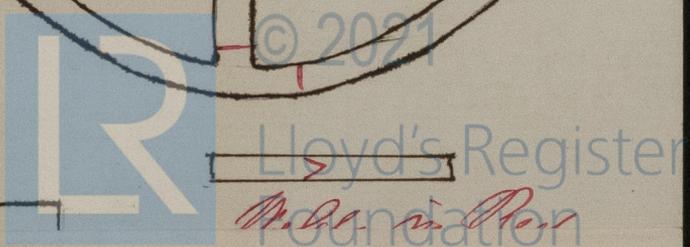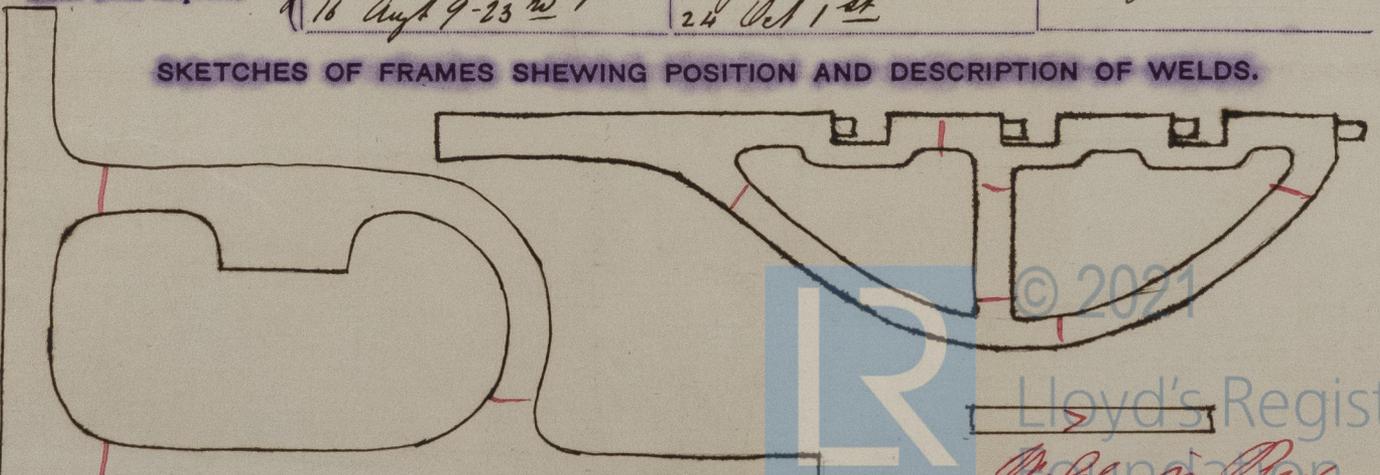

SLD948-0098