

# Lloyd's Register of British and Foreign Shipping.

(Received in the London Office, .....

F.

No. 259

## REPORT ON SHIP FORGINGS.

Sir,

I beg leave to report that the undermentioned Forgings, manufactured by Superior Iron Works Co. of Newcastle for the Vessel No. 120, being built by Superior Iron Works Co. of Sunderland have been inspected by me in course of being forged and smithed, and found to be, so far as can be seen, sound and efficient.

M 5/9/83

Mark on Forging.

Lloyd's

No 259  
H.B. 8/83

I am, Sir,

Your Obedient Servant,


H. Cameron.

The Secretary,  
London.

Sunderland

	STERN FRAME.	RUDDER FRAME.	STEM.
Material*	Scrap Iron	Scrap Iron	Scrap Iron
How made	Forged	Forged	Forged
Dimensions	10' x 6'	7 3/4' x 3 3/4'	10' x 2 3/4'
Progress on Inspection	Forging & smithing	Forging & smithing	Forging
Dates when Inspected	March 25-30 April 12-23 25 May 1-7	July 16-18-22-30 Aug 2 10-14-18-21-28	April 23-25 May 1-6

SKETCHES OF FRAMES SHEWING POSITION AND DESCRIPTION OF WELDS.

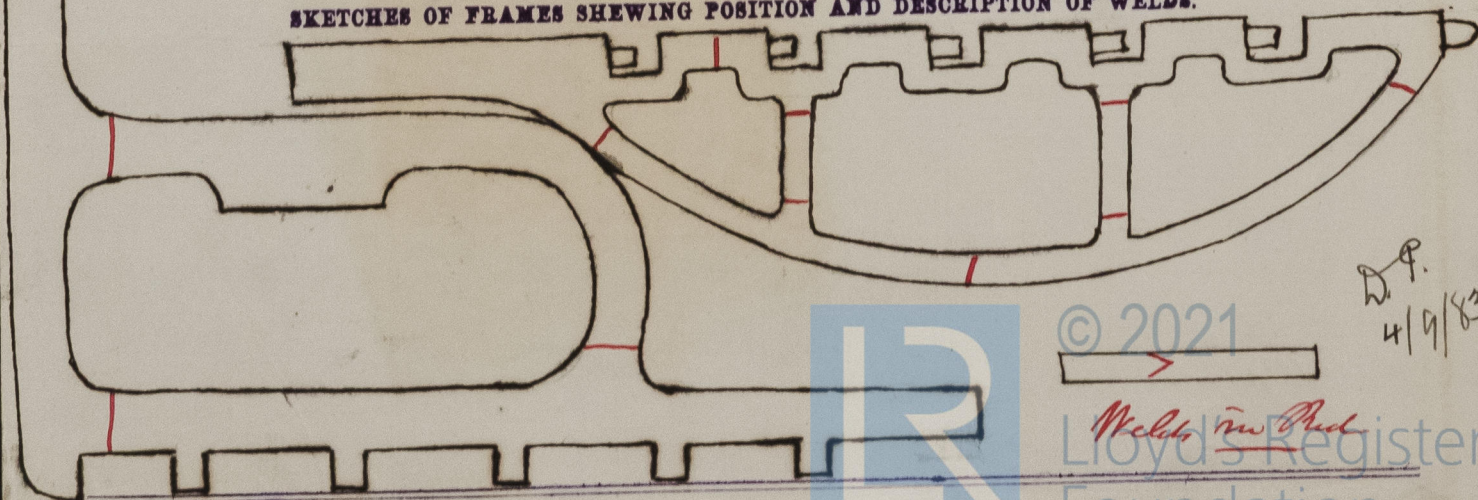

D.P.  
4/9/83

\* If of iron, state whether scrap or puddled iron.