

18-19 Jan

St. Cortés old Rpt. 13507

Midship Section.

1/2 Girth 28.00
1/2 Breadth 16.00
Depth. 15.42

59.42.219.83.
130622.

Screw Steamer ^{Lot} No. 29849.

Scale $\frac{1}{2}'' = 1 \text{ Foot.}$

Class Spar deck 100 A.


Rule 1883.

Proportions.

Depth in L. to Main Deck 14.25.
Depth in L. to Spar Deck 9.48.
Breadth in L. 6.80.

Dr. H. G.

27/3/84.

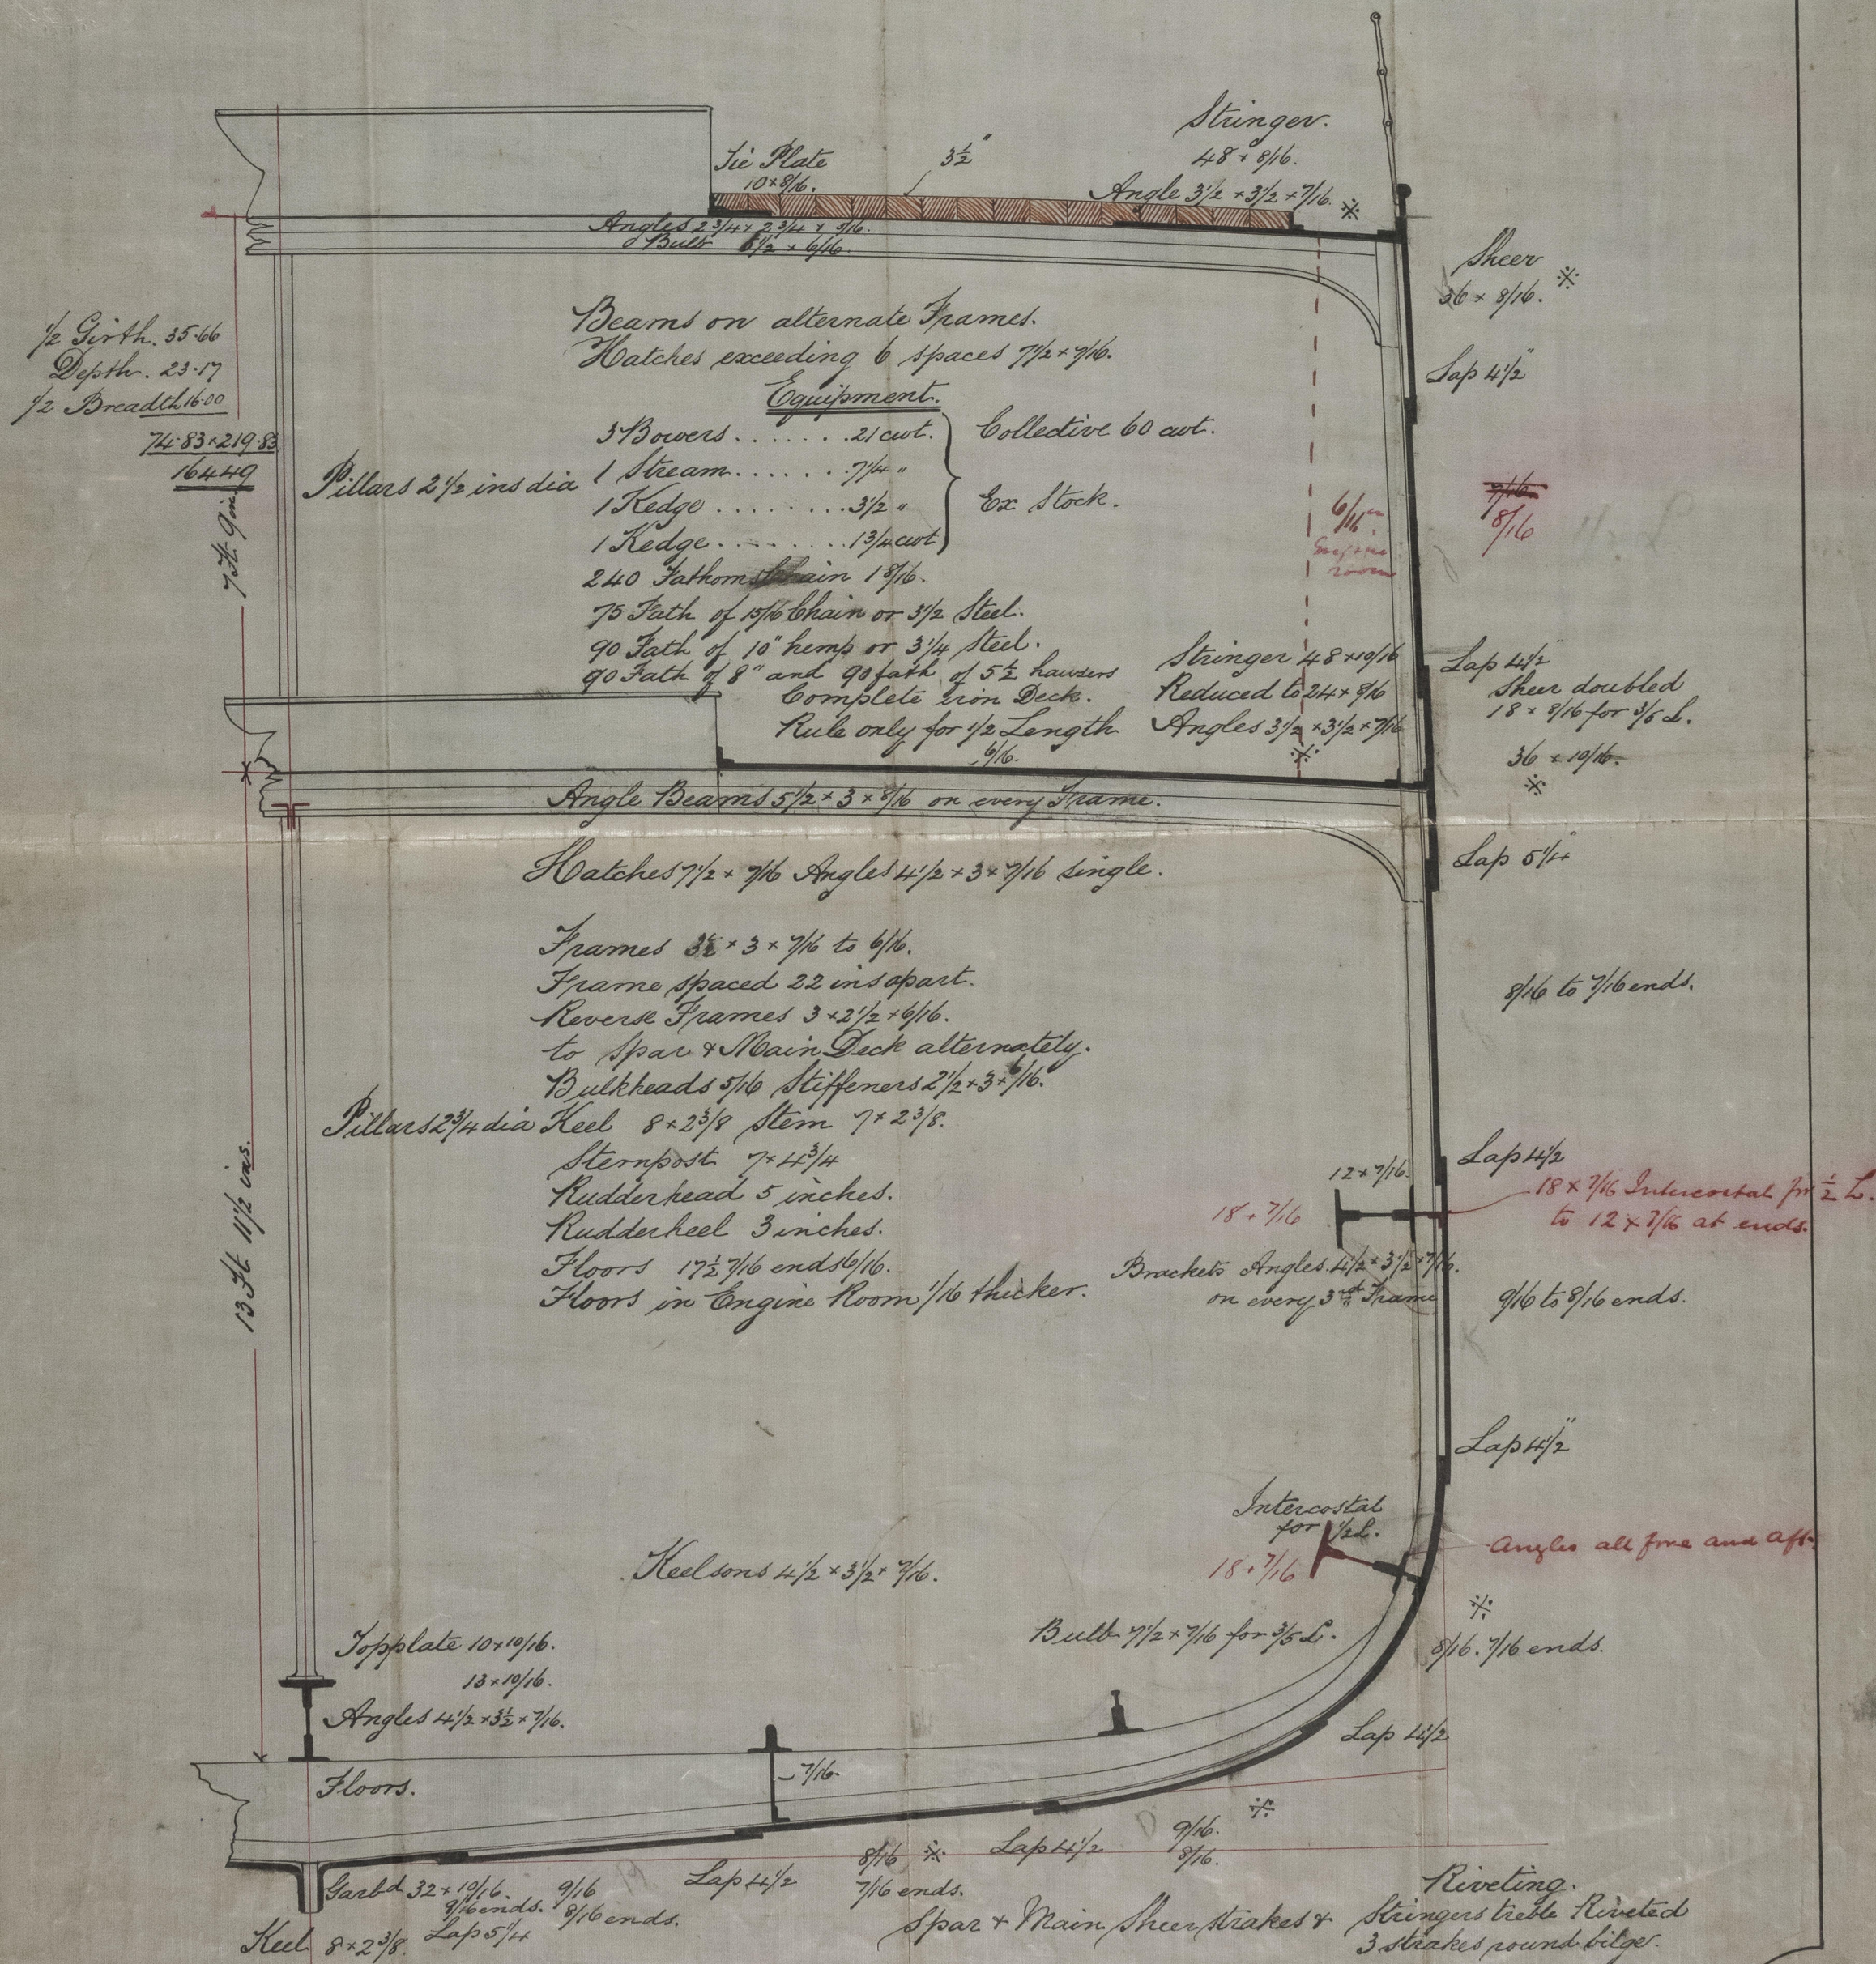

Riveting.
ingers treble Riveted
takes pound bilges.

27/3/84