

Lloyd's Register of British and Foreign Shipping.

(Report on Vessel No. 13,504 Port Sunderland)No. 65A

SHIP FORGINGS OR CASTINGS.

I have to report that the undermentioned Iron or Steel Forgings or Castings, manufactured by

Messrs C H Reid & Co.

of

Sunderlandfor the Vessel No. 299, being built by Mr James Laingof Sunderland have been inspected by me as set forth below, and foundto be, so far as can be seen, sound.

Mark on Forgings.

Lloyd's

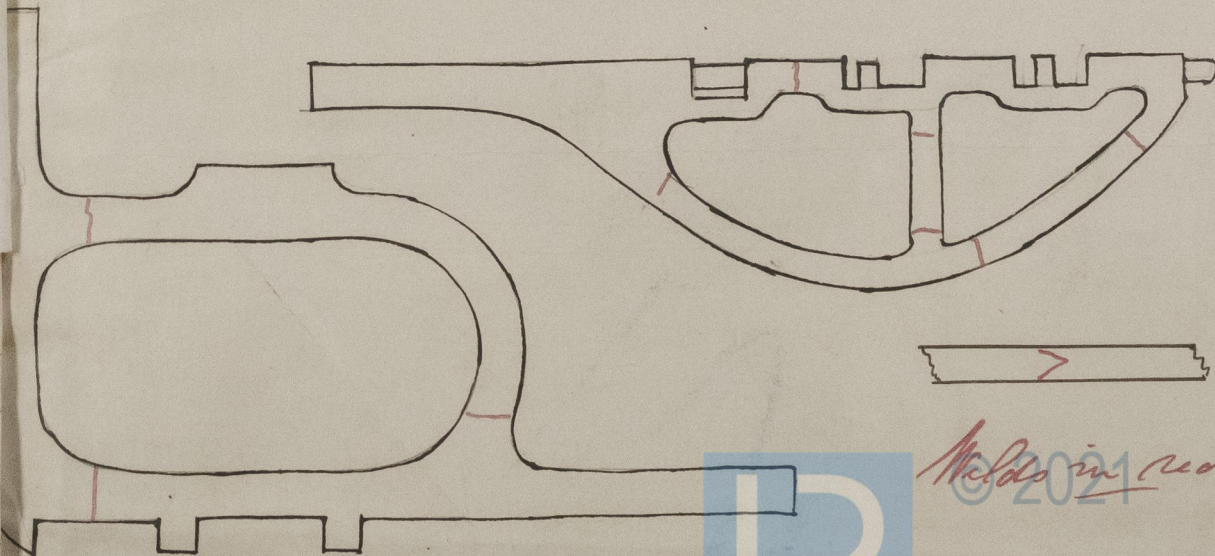
No. 65A

H.C.

H B CameronSunderland

	STERN FRAME.	RUDDER FRAME.	STEM.
Material* - - -	<u>Scrap Iron</u>	<u>Scrap Iron</u>	
How made - - -	<u>Forged</u>	<u>Forged</u>	
Dimensions - - -	<u>7' x 4 1/4"</u>	<u>5 1/2' x 3"</u>	
Progress on Inspection -	<u>Forged & Smithed</u>	<u>Smithed</u>	<u>Not seen</u>
Dates when Inspected	<u>March 14-21-26 April 3/84</u>	<u>May 6. 23-29/84</u>	

SKETCHES OF FRAMES SHEWING POSITION AND DESCRIPTION OF WELDS OF FORGINGS, OR PARTICULARS OF TESTS APPLIED TO CASTINGS.

Welds in red