


er. to sld  
12/12/84

Pipe Plan No 126<sup>5/2</sup> 127- 129<sup>3/5</sup>  
Scale 1/4" = 1 Foot

Iron S.S. 'Serricornis' Sld. report No. 13461.

M  
11.12.84

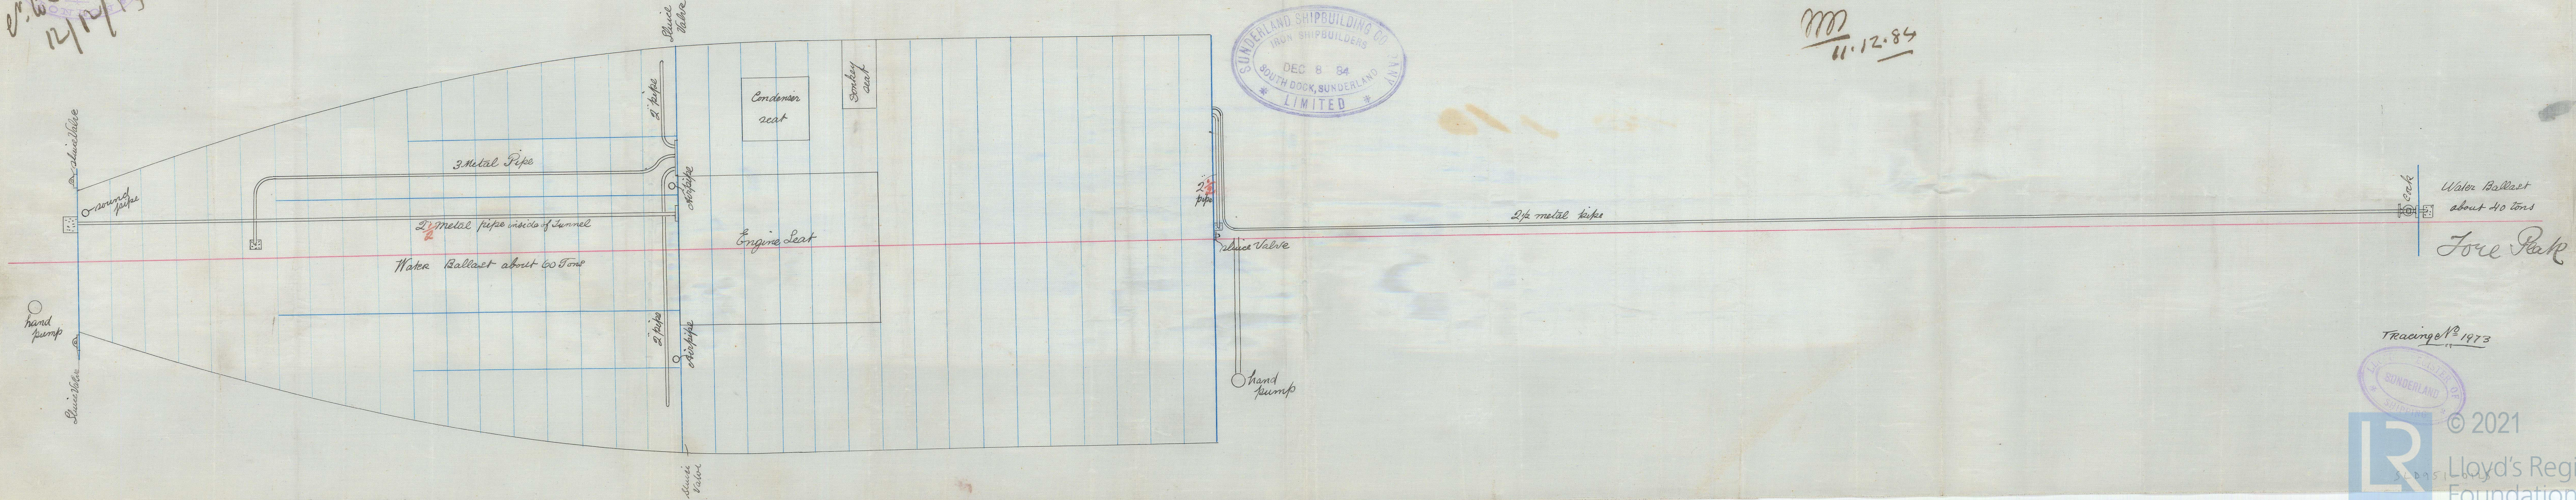

Tracing No 1973

