

## Lloyd's Register of British and Foreign Shipping.

(Report on Vessel No. 13461 Port Sunderland)No. 182A

## SHIP FORGINGS OR CASTINGS.

I have to report that the undermentioned Iron or Steel Forgings or Castings, manufactured by

Messrs J. Barnbridge & Co. of Pallionfor the Vessel No. 129, being built by The Sunderland S.B. Co.of Sunderland have been inspected by me as set forth below, and found to be, so far as can be seen, sound.

on Forgings.

Lloyd's


No. 182A

S.B. Co.

Hugh Cameron  
Sunderland

	STERN FRAME.	RUDDER FRAME.	STEM.
* - - - -	<u>Scrap Iron</u>	<u>Scrap Iron</u>	<u>Scrap Iron</u>
ade - - - -	<u>Forged</u>	<u>Forged</u>	<u>Forged</u>
ons - - - -	<u>6 1/4" x 3 1/4"</u>	<u>3 3/4" - 2 1/4"</u>	<u>6 1/4" x 1 5/8"</u>
s on Inspection -	<u>Forged Smithed</u>	<u>Forged Smithed</u>	<u>Forged</u>
hen Inspected	<u>Nov 11-14-19. 24-28/84</u>	<u>Nov 10. 17. 19. 21/85</u>	<u>Nov 19/84</u>

ETCHES OF FRAMES SHEWING POSITION AND DESCRIPTION OF WELDS OF FORGINGS, OR PARTICULARS OF TESTS APPLIED TO CASTINGS.

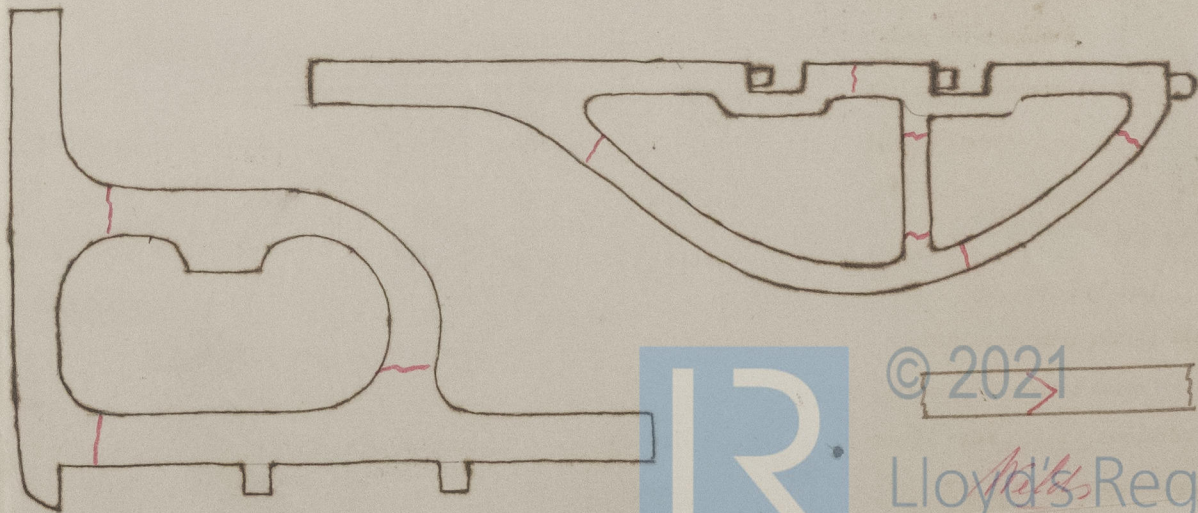

© 2021

Lloyd's Register  
Foundation