

Lloyd's Register of British and Foreign Shipping.

(Report on Vessel No. 13441 Port Sunderland)

No. 242.A.

SHIP FORGINGS OR CASTINGS.

I have to report that the undermentioned Iron or Steel Forgings or Castings, manufactured by Messrs Bainbridge & Co. and Richardson & Sons of Sunderland & Hartlepool for the Vessel No. 210, being built by Messrs J. Thompson & Sons of Sunderland have been inspected by me as set forth below, and found to be, so far as can be seen, sound.

Stem Kuls by Messrs J. Richardson & Sons


mark on Forgings.

Lloyd's
No. 242.A.
H.C.

Wm. Cameron,
Sunderland.


	STERN FRAME.	RUDDER FRAME.	STEM.
Material*	Scrap Iron	Scrap Iron	Scrap Iron
How made	Forged	Forged	Forged
Dimensions	9" x 5 1/2"	4" x 3 1/2"	9 1/2" x 2 1/2"
Press on Inspection	Forged Smithed	Forged Smithed	Forged
When Inspected	March 10-14-19-21-31 April 9-10/85	May 16-21 June 2-3-10/85	July 12 March 12/85

ETCHES OF FRAMES SHEWING POSITION AND DESCRIPTION OF WELDS OF FORGINGS, OR PARTICULARS OF TESTS APPLIED TO CASTINGS.

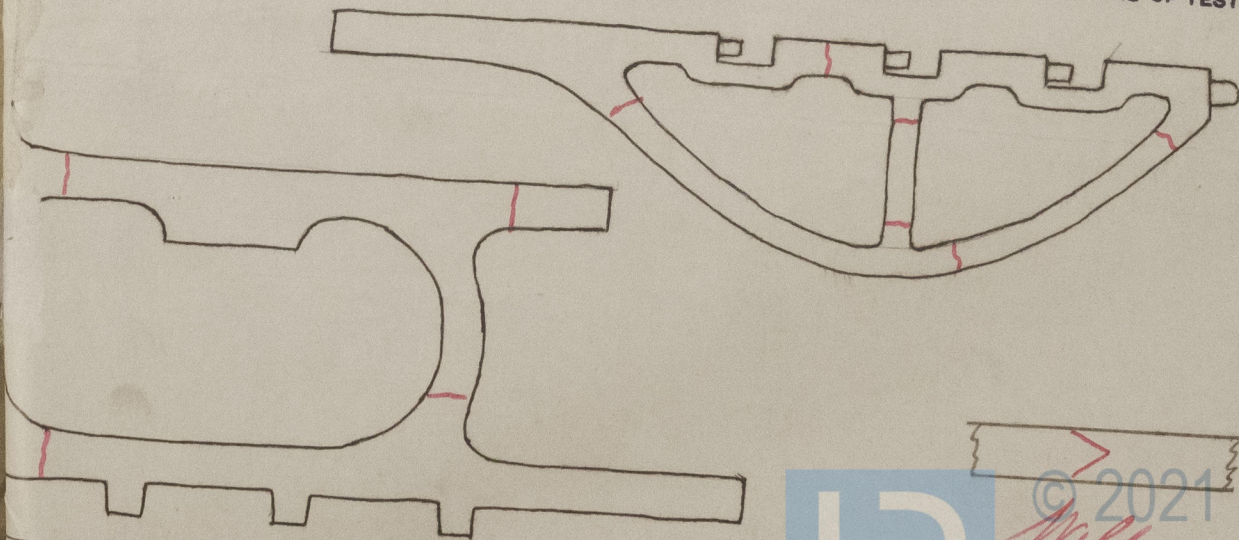

Mar./84—Trans. Ink.]

* If of Iron, state whether scrap or puddled Iron.

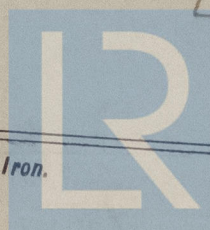

© 2021
Wm. Cameron
Lloyd's Register
Foundation

of British and