

# Lloyd's Register of British and Foreign Shipping.

(Report on Vessel No. \_\_\_\_\_)

Port \_\_\_\_\_

249.A.


## SHIP FORGINGS OR CASTINGS.

have to report that the undermentioned Iron or Steel Forgings or Castings, manufactured by  
*Messrs G H Reed & Co* of *Sunderland*  
 the Vessel No. *132*, being built by *Messrs Russell & Co.*  
*Greenock* have been inspected by me as set forth below, and found  
 so far as can be seen, *sound.*

*Henry Cameron,*  
*Sunderland.*

	STERN FRAME. <i>Port</i>	RUDDER FRAME.	STEM.
	<i>Scrap Iron</i>	<i>Scrap Iron</i>	<i>Scrap Iron</i>
	<i>Forged</i>	<i>Forged</i>	<i>Forged</i>
	<i>10' 4 3/4</i>	<i>4 1/4 - 3 1/2'</i>	<i>10' 4 3/4</i>
Inspection	<i>Smiths</i>	<i>Forged Smiths</i>	<i>Forged</i>
Inspected	<i>July 20-21-24/85</i>	<i>July 28th Aug 5-14-21 26-31/85</i>	<i>July 20-21-25/85</i>

OF FRAMES SHEWING POSITION AND DESCRIPTION OF WELDS OF FORGINGS, OR PARTICULARS OF TESTS APPLIED TO CASTINGS.

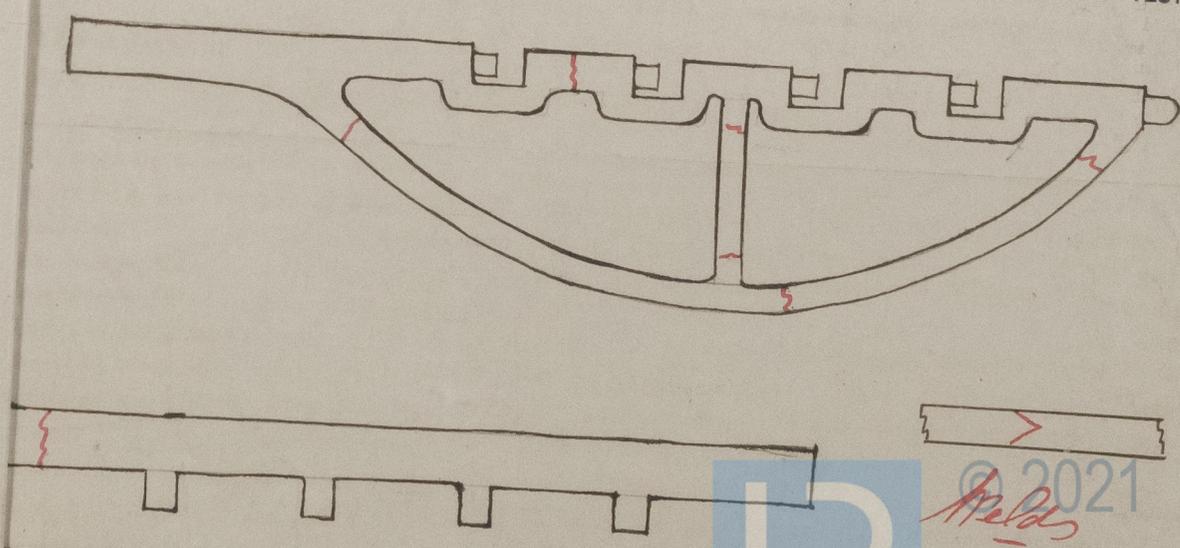

2410-15875

\* If of Iron, state whether scrap or puddled Iron.

