

dr. to Sld. 27/7/85.

S.S. "Azalea" Sld. report No 13880

GLASGOW ENGINE WORKS

BOILER

SCALE - 1 INCH TO A FOOT

WRITTEN DIMENSIONS ONLY TO BE TAKEN




From the Sunderland Shipbuilding Co. Ltd. S.S. 132

Sunderland Engine Works. Contract 337.

S.S. "Azalea."

Working pressure 90 lbs.  
Test 180 "

M 27/7/85

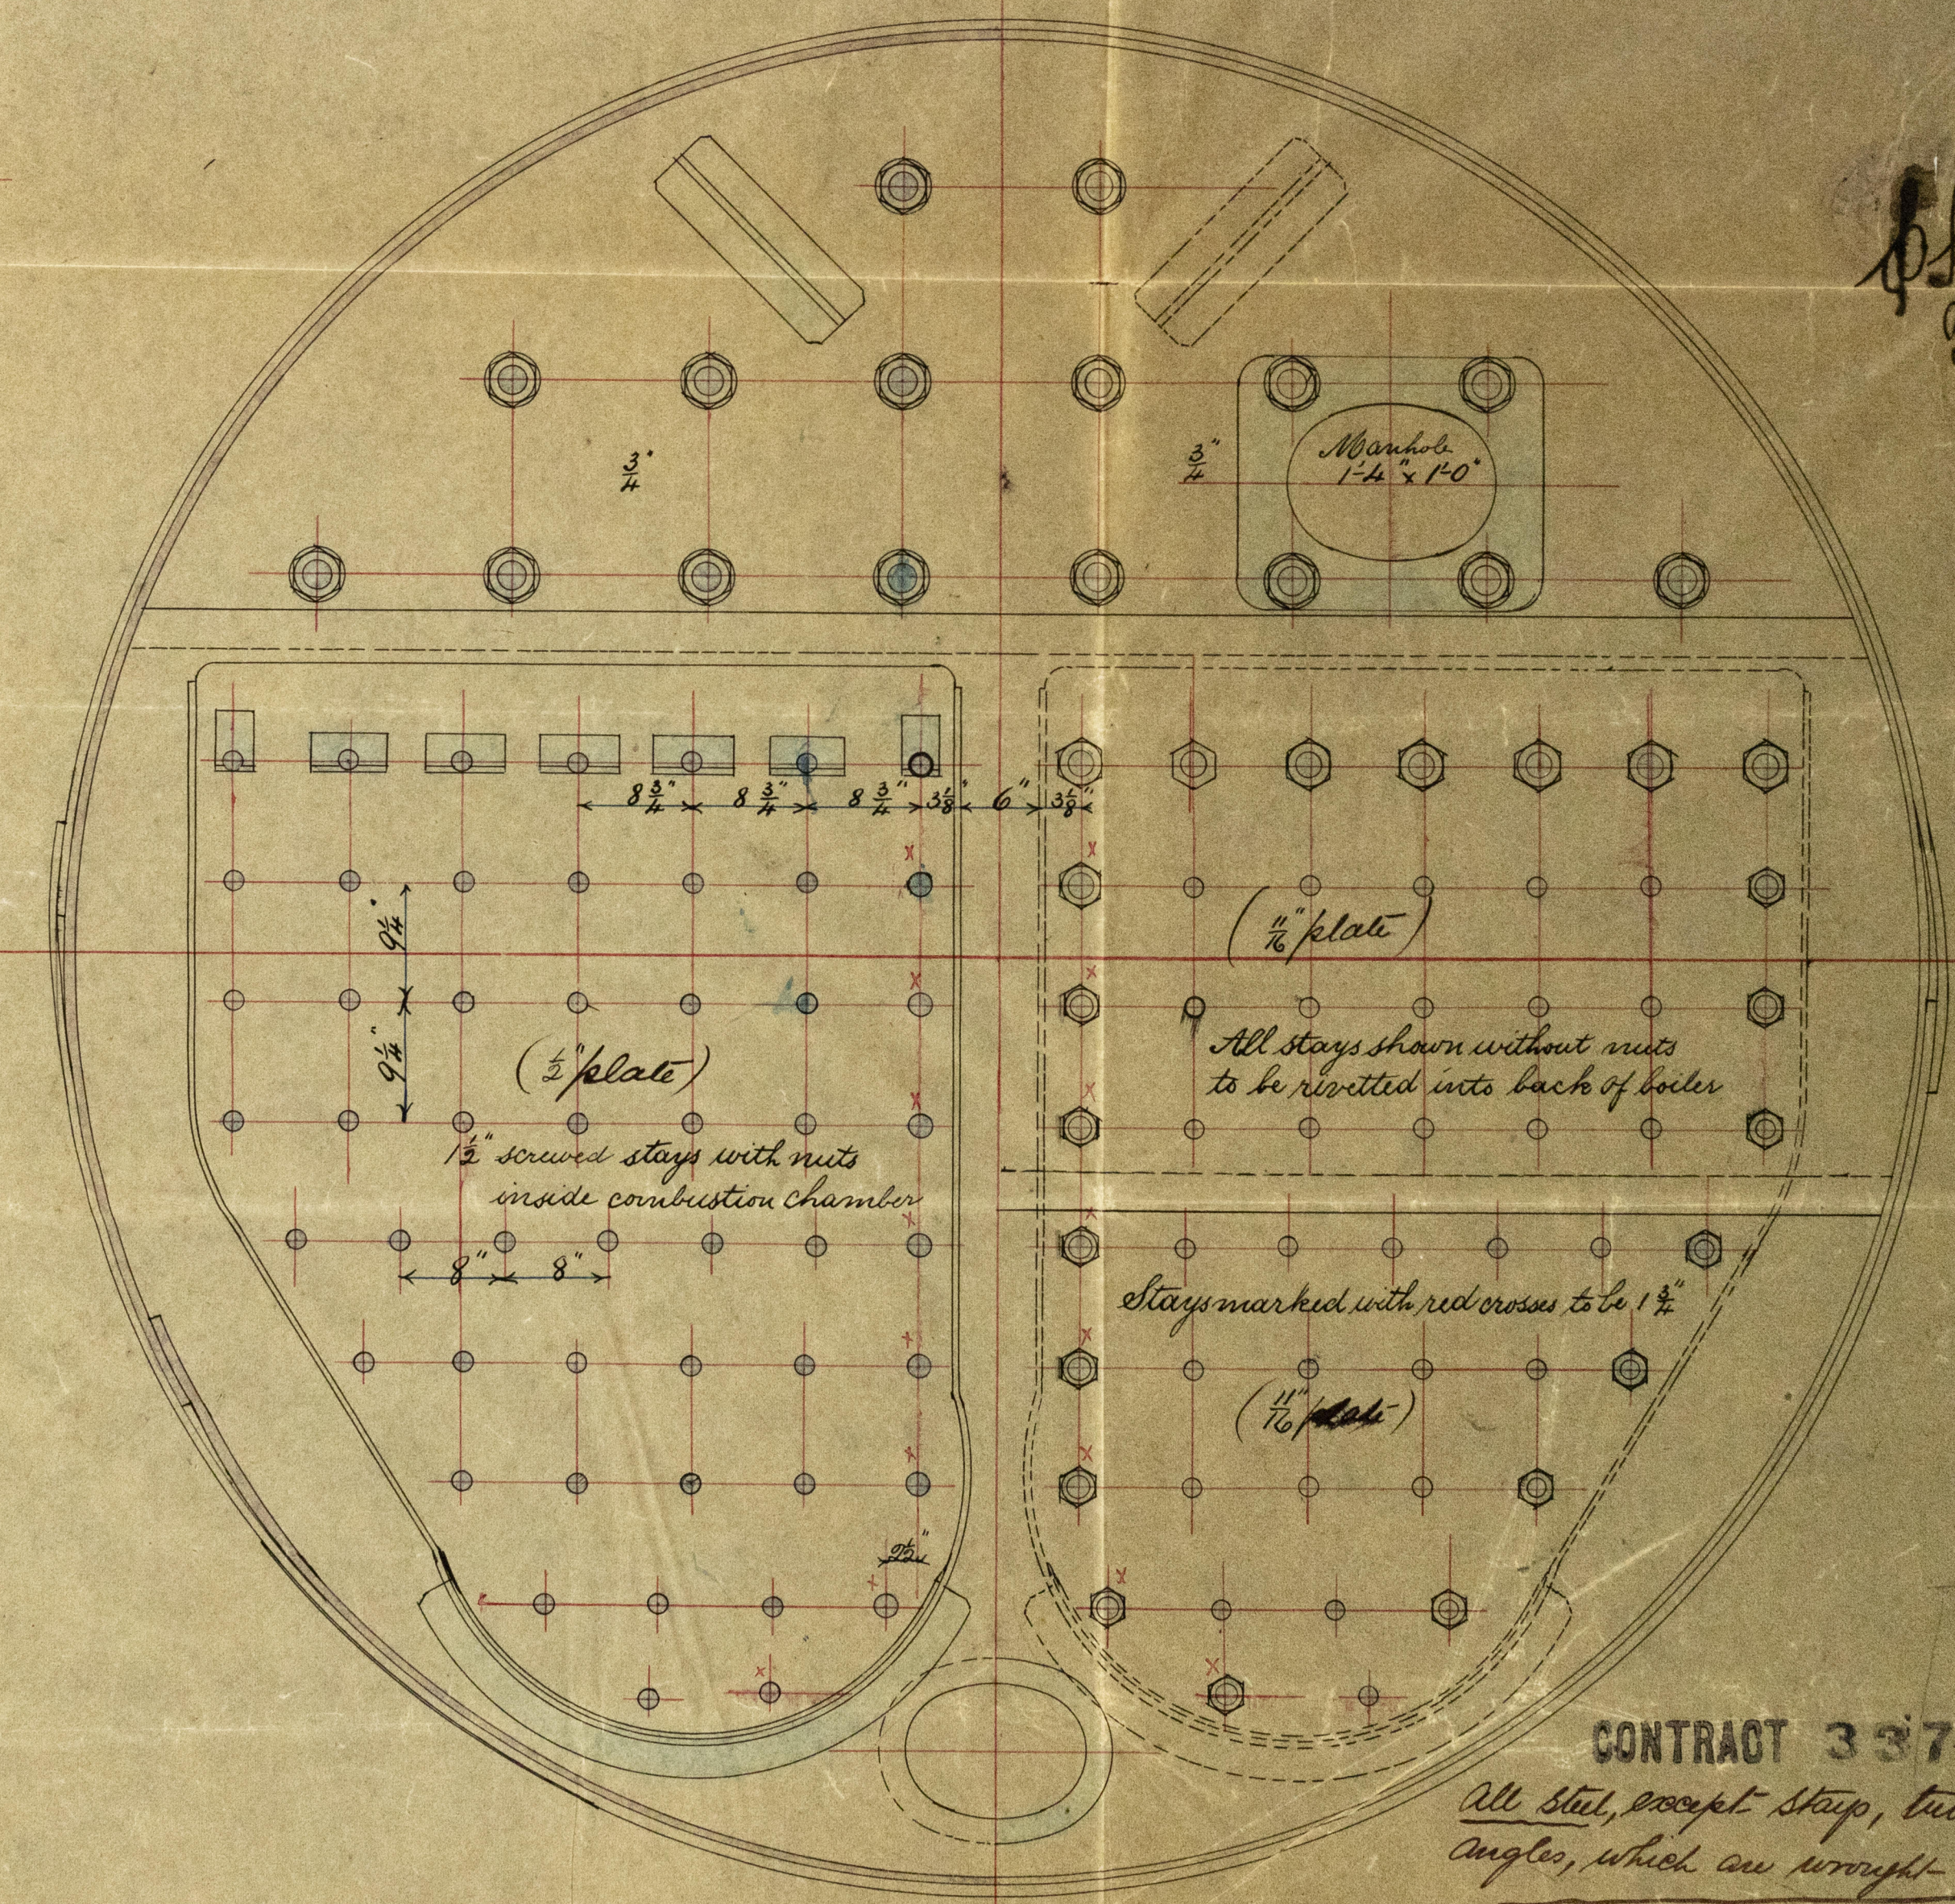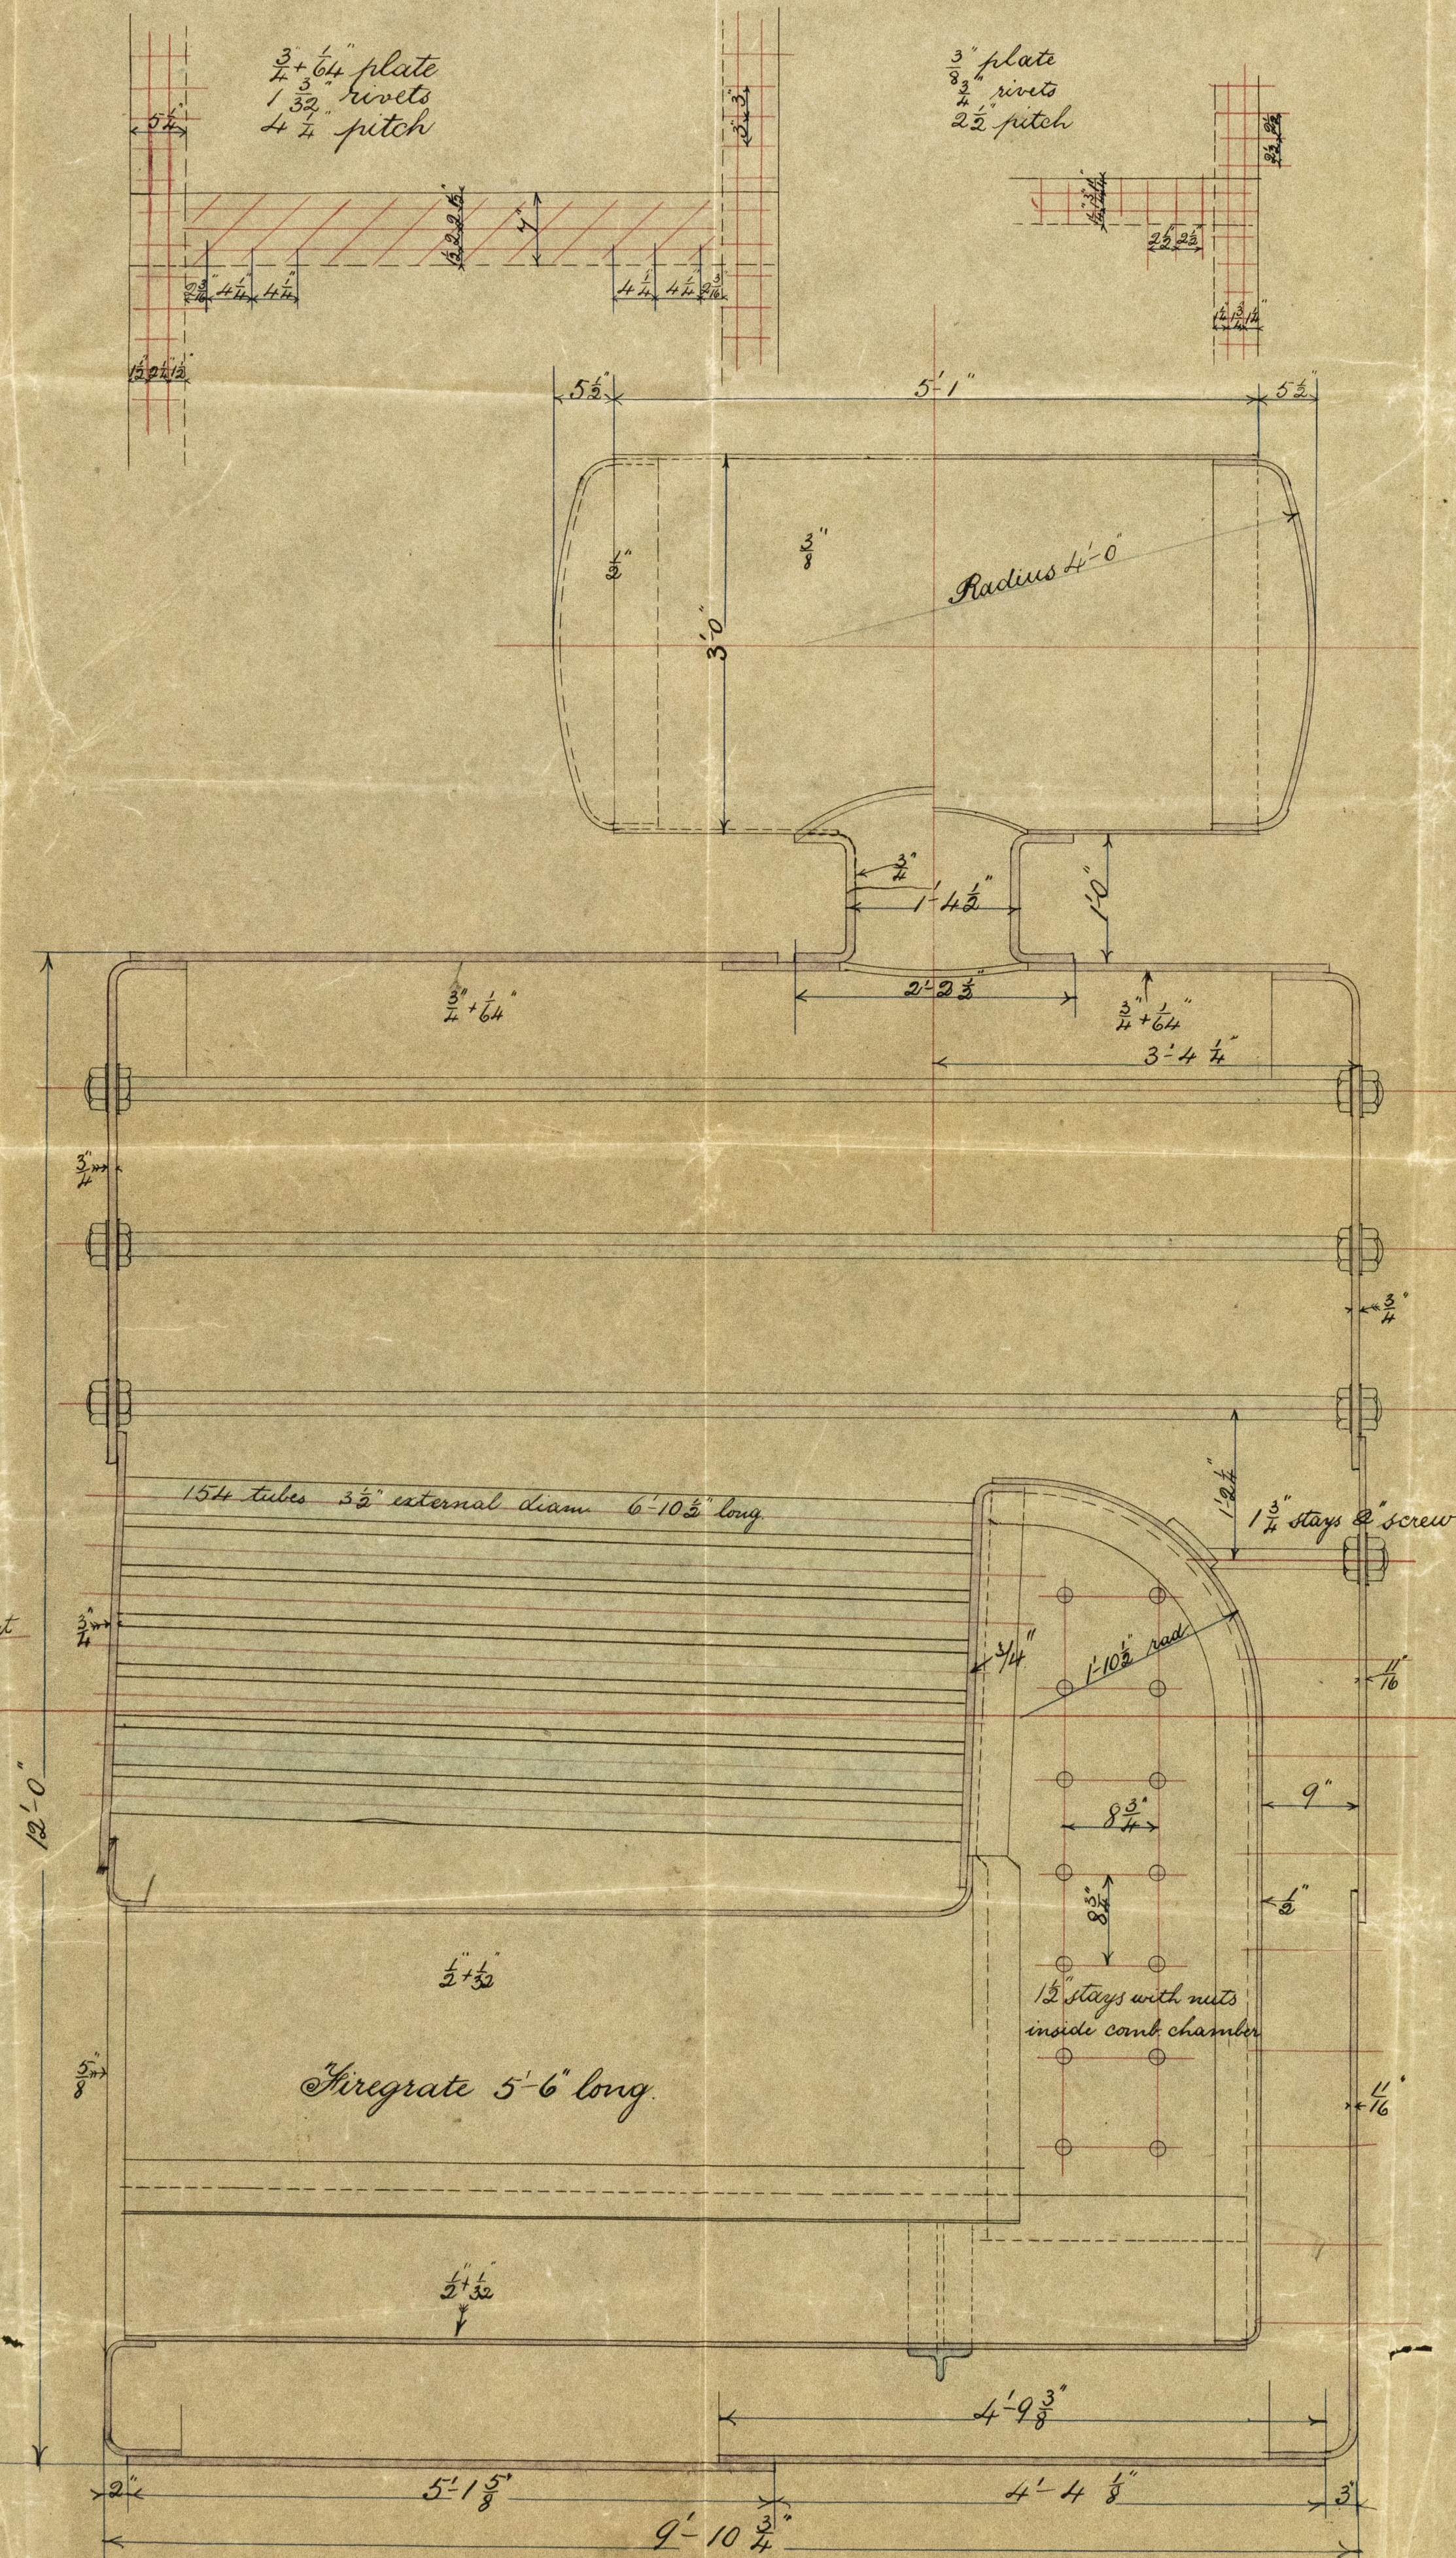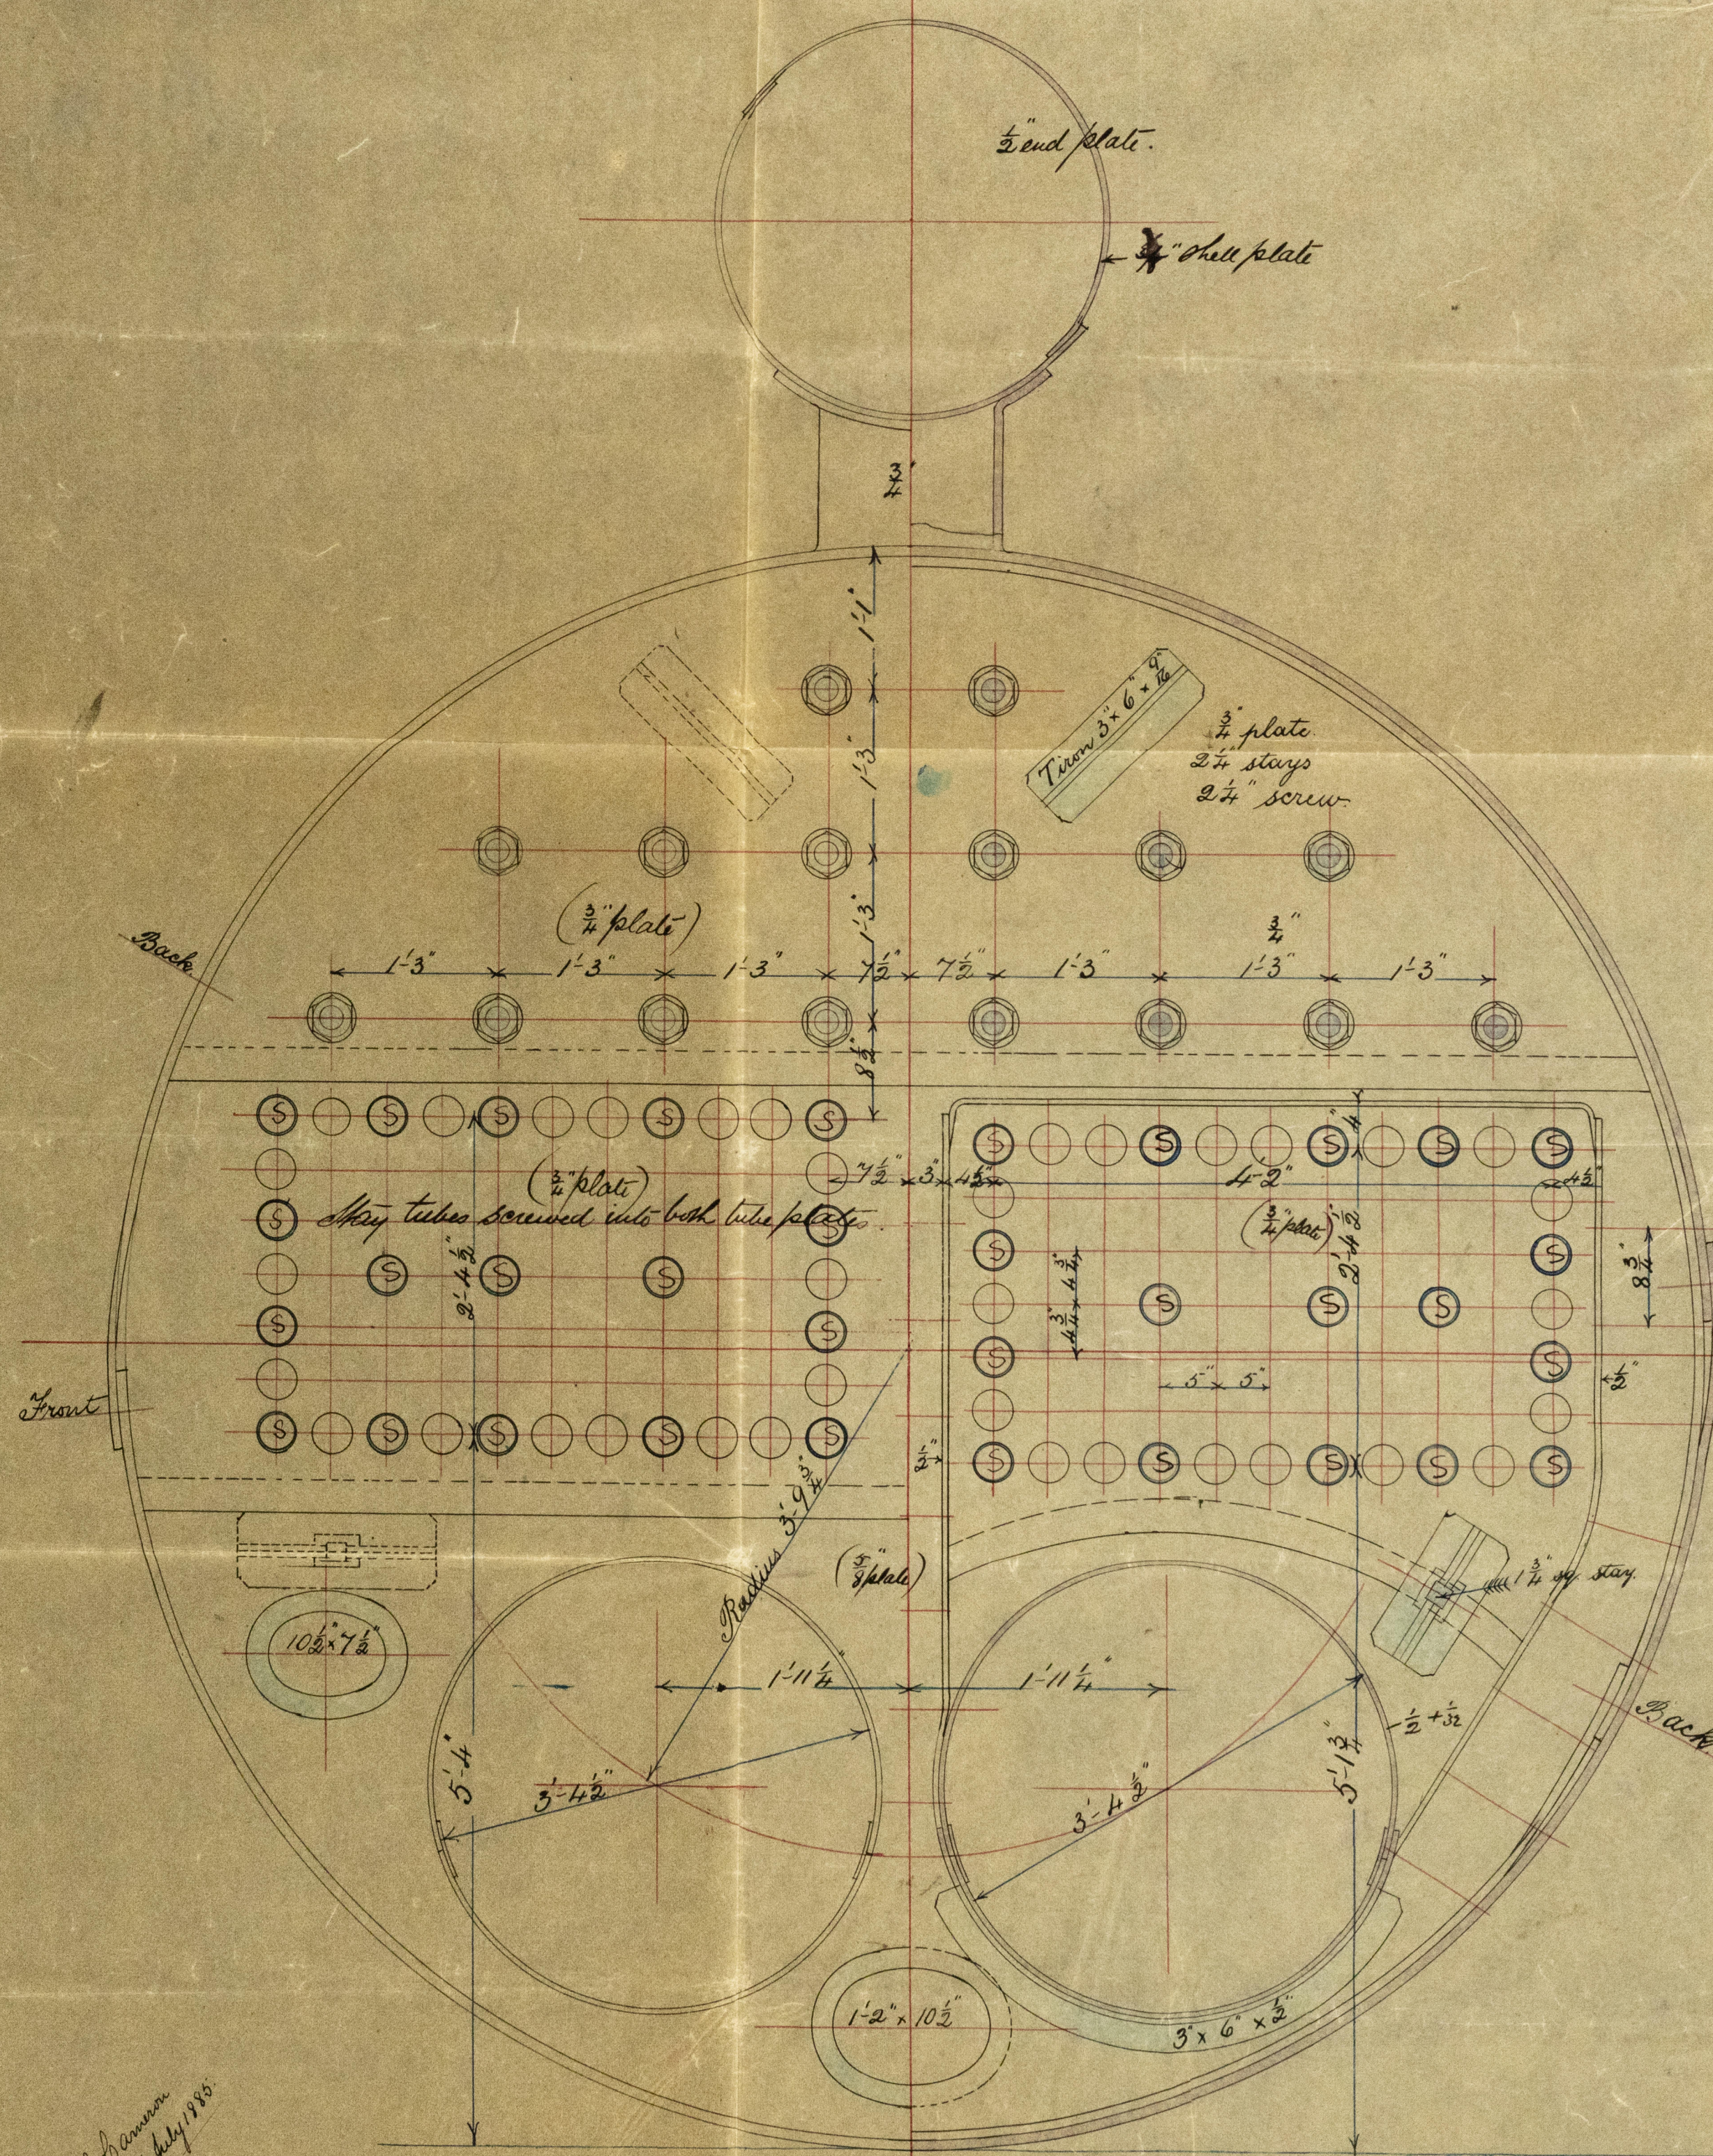

CONTRACT 337-1 off  
All steel, except stay, tubes, and  
angles, which are wrought iron