


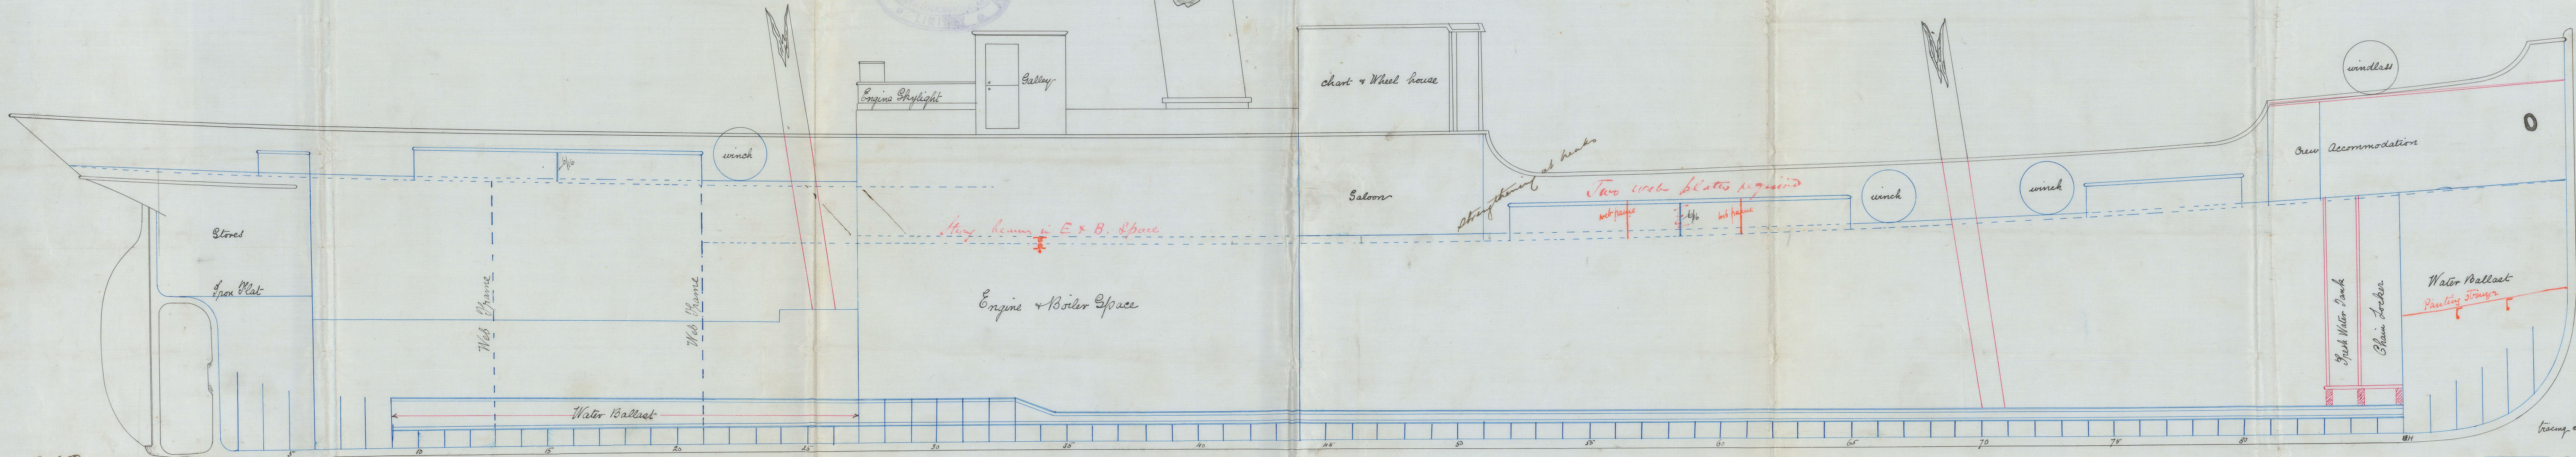

5.9.85

S. J. Hyslop Ltd. rpt. No. 13880

Longitudinal Plan No 132  
Scale 1/8" = 1 Foot



S. J. Hyslop  
5/9/85

Tracing No 2201