



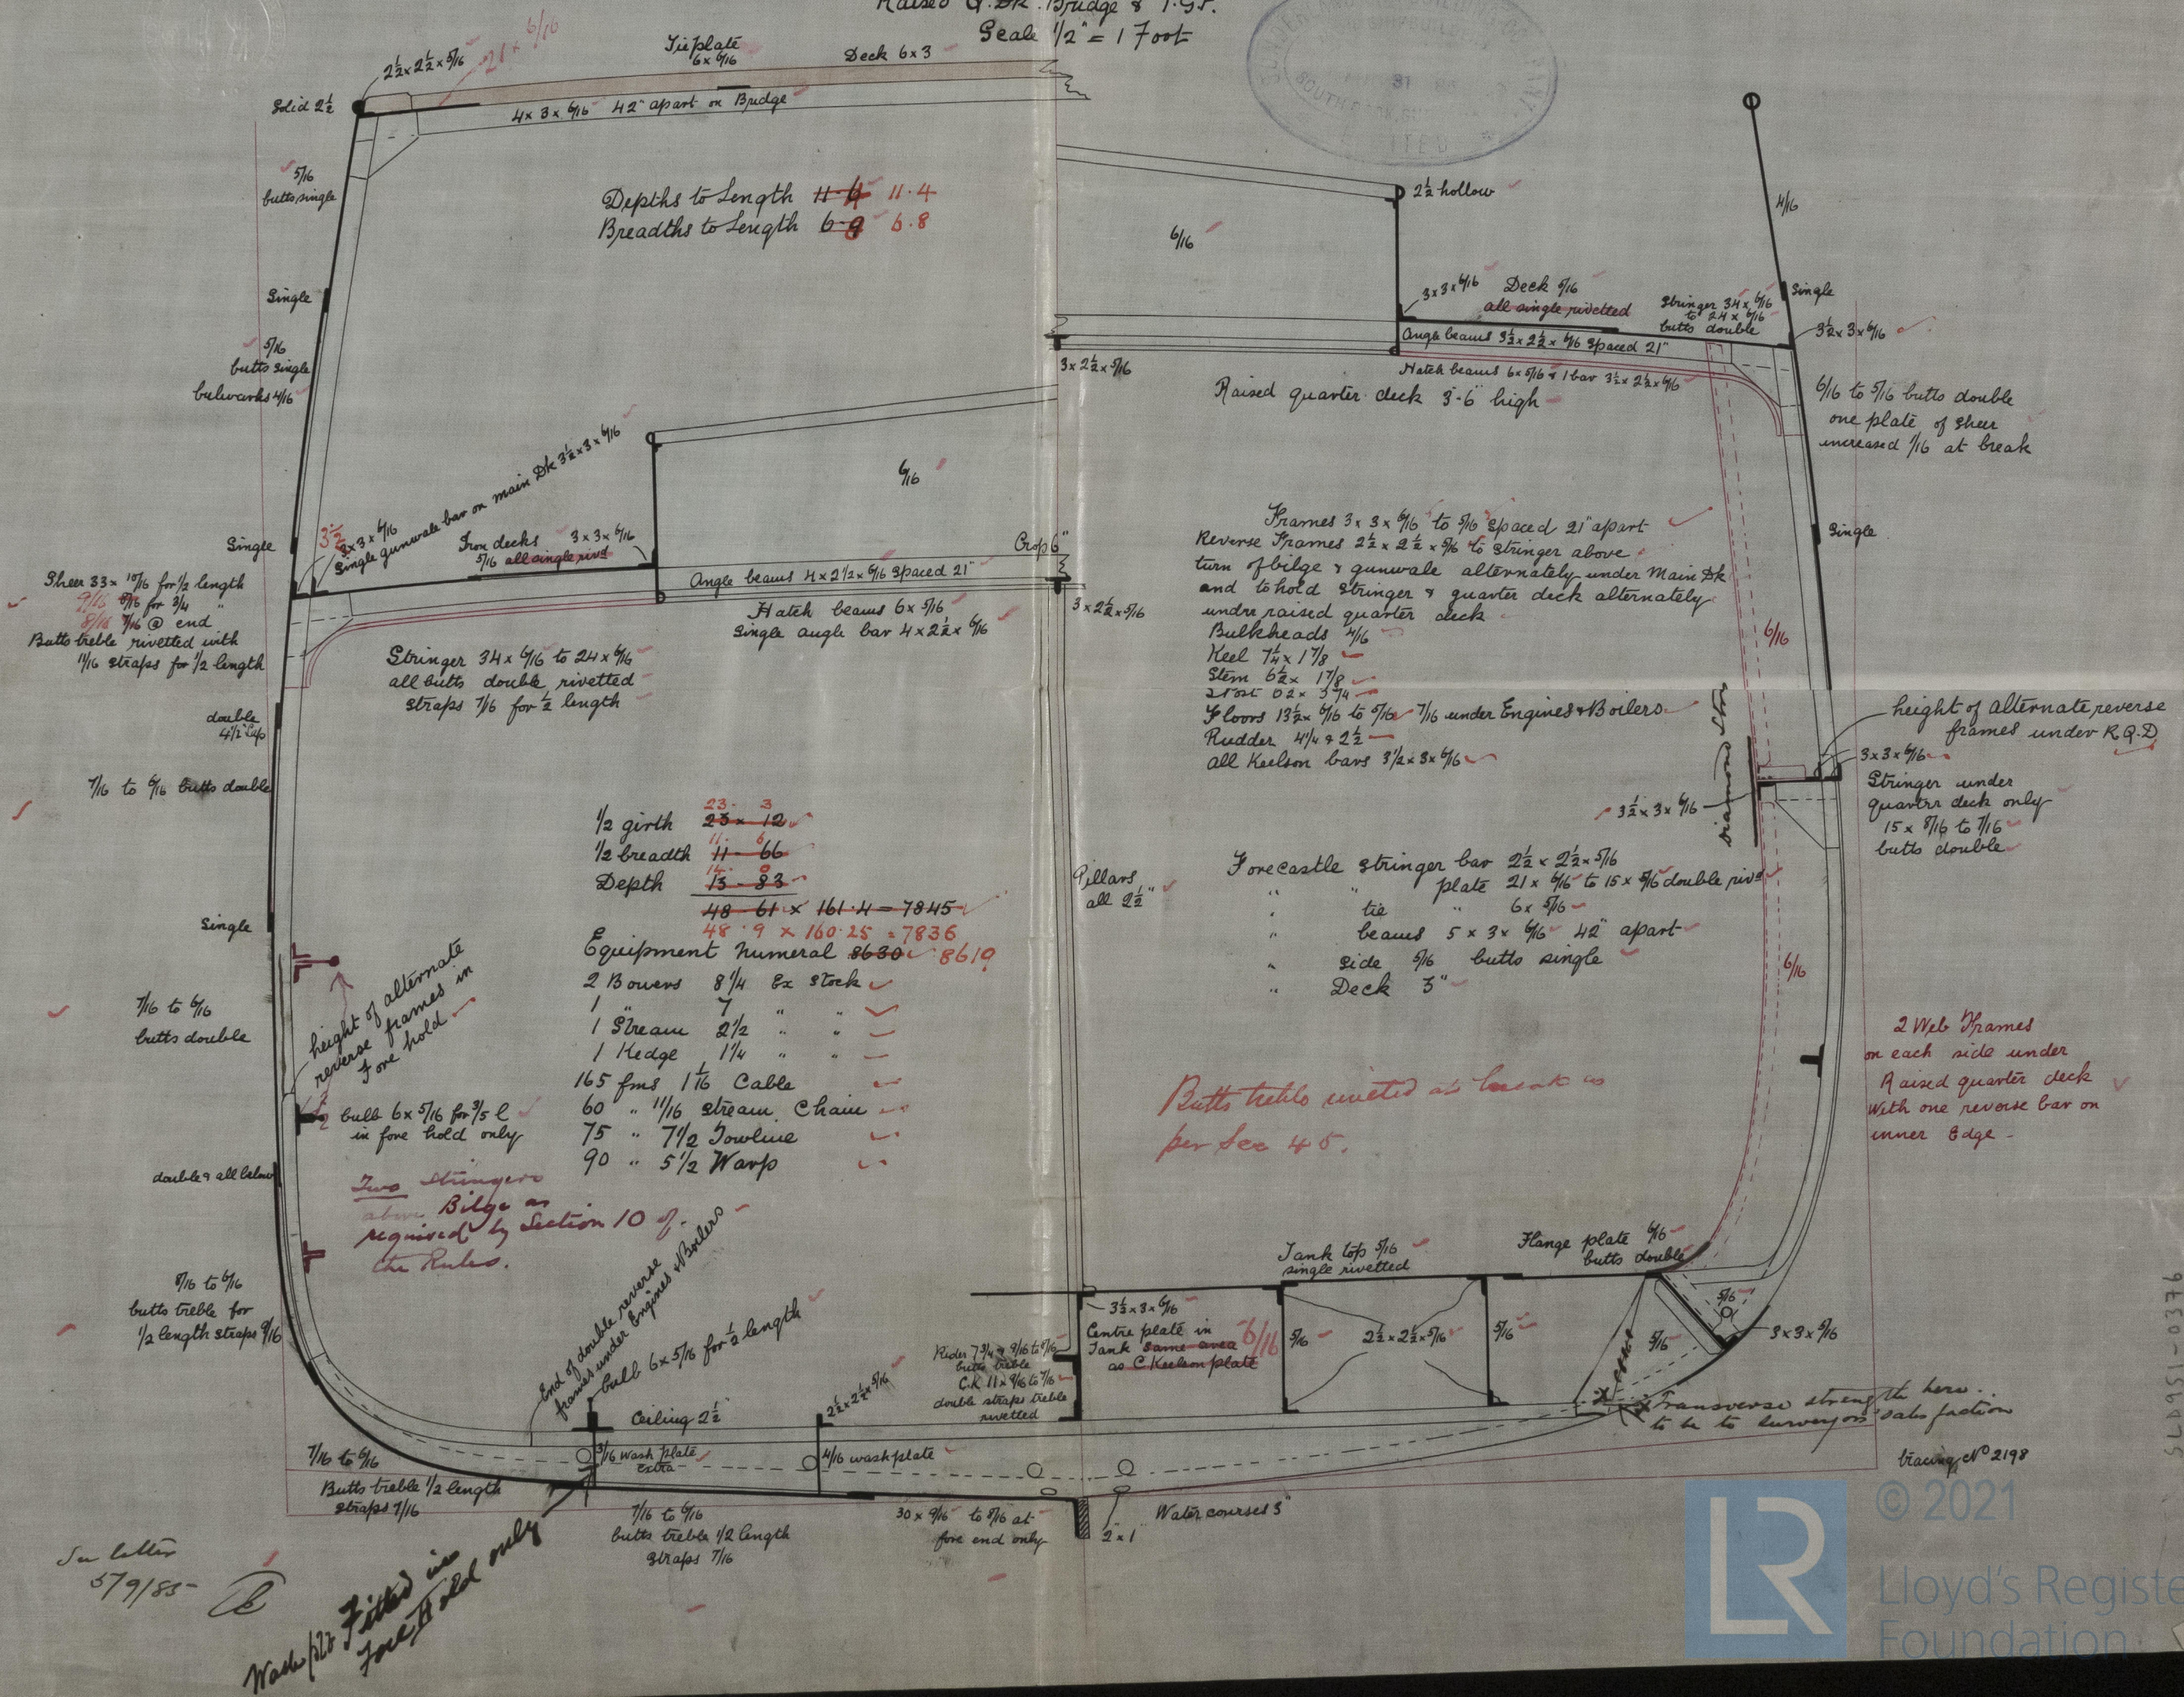

5.9.85

72132
Length B.P. 162.6
Breadth Ex 23.6
Depth to floors 12.10 12.10 1/2
Depth moulded 13.4 13.6
Class 100-A.1
Raised Q. Deck Bridge & T.G.F.
Scale 1/2" = 1 Foot

S.S. Nyalea Sld. rpi No. 13880

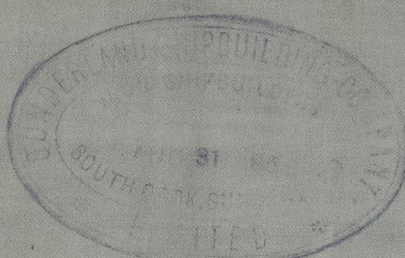

1/2 girth 23.3
1/2 breadth 11.66
Depth 13.83
48.61 x 161.4 = 7845
48.9 x 160.25 = 7836
Equipment numeral 8630 8619
2 Bowers 8 1/4 Ex stock
1 Stream 2 1/2 " "
1 Hedge 1 1/4 " "
165 fms 1 1/16 Cable
60 " 1 1/16 stream Chain
75 " 7 1/2 Towline
90 " 5 1/2 Warp

Frames 3 x 3 x 7/16 to 7/16 spaced 21" apart
Reverse Frames 2 1/2 x 2 1/2 x 7/16 to stringer above
turn of bilge & gunwale alternately under Main Dk
and to hold stringer & quarter deck alternately
Bulkheads 4 1/16
Keel 7 1/4 x 1 7/8
Stem 6 1/2 x 1 7/8
2 x 102 x 5 3/4
Floors 13 1/2 x 7/16 to 7/16 7/16 under Engines & Boilers
Rudder 4 1/4 x 2 1/2
all Keelson bars 3 1/2 x 3 x 7/16

Forecastle stringer bar 2 1/2 x 2 1/2 x 7/16
plate 21 x 7/16 to 15 x 7/16 double rivet
tie 6 x 7/16
beams 5 x 3 x 7/16 42" apart
side 7/16 butts single
Deck 3"

2 Web Frames on each side under raised quarter deck with one reverse bar on inner edge

Butts treble rivetted as before per Sec 45.

In letter 57/85

Wash plate fitted in fore hold only

SLD951-0376