


FF30-127003

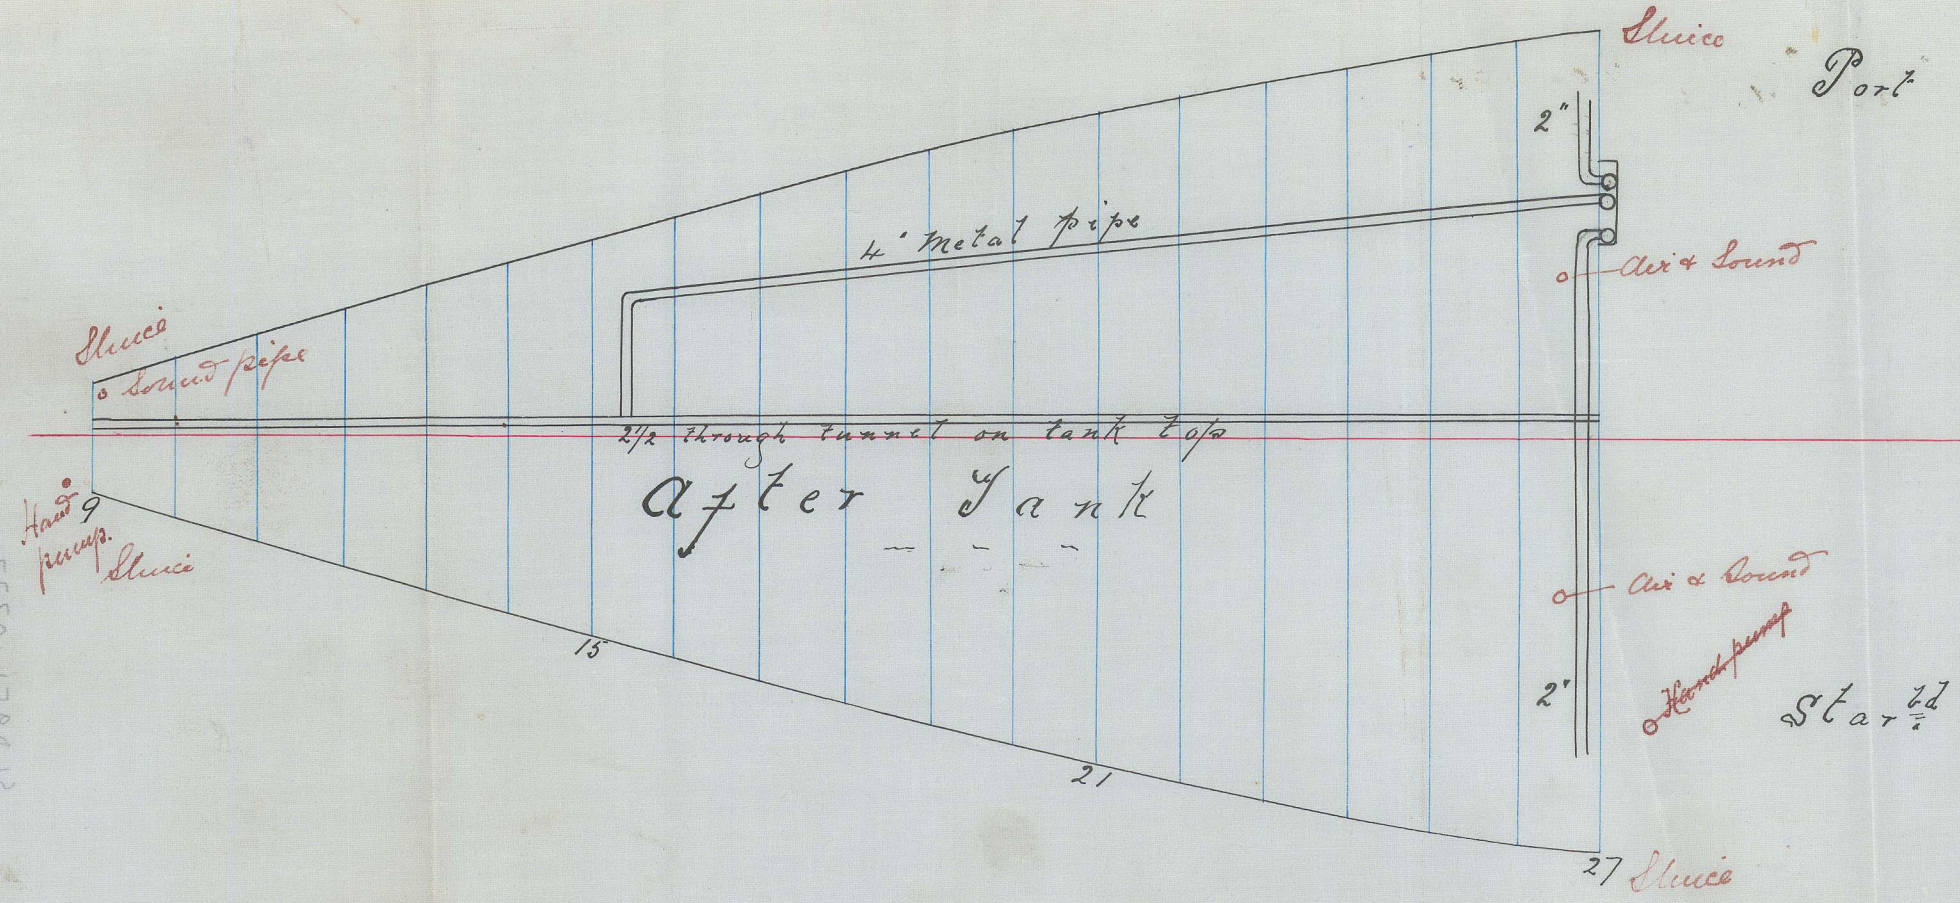

Same as our
Nos. 126. 127. 129.

Engine and Boiler Space

Pipe Plan No 132 5/5
Scale 1/4" = 1 Foot



Fore hold

S. S. Hyalea Sld. rpt No 13880

W.A. 19/12/85



Fore Peak Tank