

Lloyd's Register of British and Foreign Shipping.

(Report on Vessel No. 13880 Port Sunderland)

2. 340. a SHIP FORGINGS OR CASTINGS.

I have to report that the undermentioned Iron or Steel Forgings or Castings, manufactured by Messrs. The Mearns Quay Forge Co. of Sunderland for the Vessel No. 132, being built by Messrs. The Sunderland S.W.C. of Sunderland have been inspected by me as set forth below, and found to be, so far as can be seen, sound.


Hugh Cameron
Sunderland

on Forgings.

Lloyd's
2. 340. a
10.56

	STERN FRAME.	RUDDER FRAME.	STEM.
* - - - -	Scrap iron	Scrap iron	Scrap iron
made - - - -	Forged	Forged	Forged
ions - - - -	6 1/2" x 3 3/4"	4 1/4" - 2 1/2"	6 1/2" x 1 7/8"
s on Inspection -	Forged & smithed	Forged & smithed	Forged
When Inspected	Sept 5-23-26/85	Nov 10-12-16/85	Sept 5/85

ETCHES OF FRAMES SHEWING POSITION AND DESCRIPTION OF WELDS OF FORGINGS, OR PARTICULARS OF TESTS APPLIED TO CASTINGS.

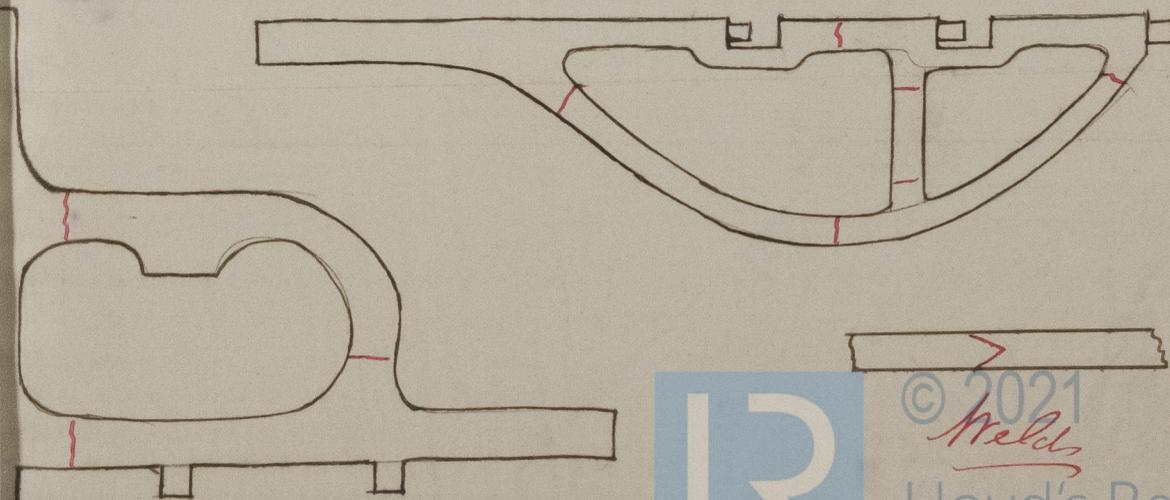

© 2021
Welds
Lloyd's Register
Foundation

SLD951-0382