

Lloyd's Register of British and Foreign Shipping.

(Report on Vessel No. 13938 Port Sunderland.)

No. 303.A.

SHIP FORGINGS OR CASTINGS.

I have to report that the undermentioned Iron or Steel Forgings or Castings, manufactured by

Messrs J Richardson & Co of Bathfords
 for the Vessel No. 211, being built by Messrs J & L Thompson & Co
 of Sunderland have been inspected by me as set forth below, and found
 to be, so far as can be seen, sound and efficient

The records FORGINGS or CASTINGS, IRON or STEEL, should be struck out as may be required.


Mark on Forgings.

Lloyd's
 No. 303.A.
 R.C.

Henry Cameron
Sunderland

	STERN FRAME.	RUDDER FRAME.	STEM.
Material*	<u>Scrap iron</u>	<u>Scrap iron</u>	<u>Scrap iron</u>
How made	<u>Forged</u>	<u>Forged</u>	<u>Forged</u>
Dimensions	<u>11 x 6 1/2"</u>	<u>8 1/2"</u>	<u>11 x 2 3/4"</u>
Progress on Inspection	<u>Smithed</u>	<u>Forged Smithed</u>	<u>Forged</u>
Dates when Inspected	<u>April 21-29 May 4-6</u> <u>12-15-18-22/85</u>	<u>May 4-6-12-15-18-22</u> <u>June 8-18-22/85</u>	<u>April 21/85</u>

SKETCHES OF FRAMES SHEWING POSITION AND DESCRIPTION OF WELDS OF FORGINGS, OR PARTICULARS OF TESTS APPLIED TO CASTINGS.

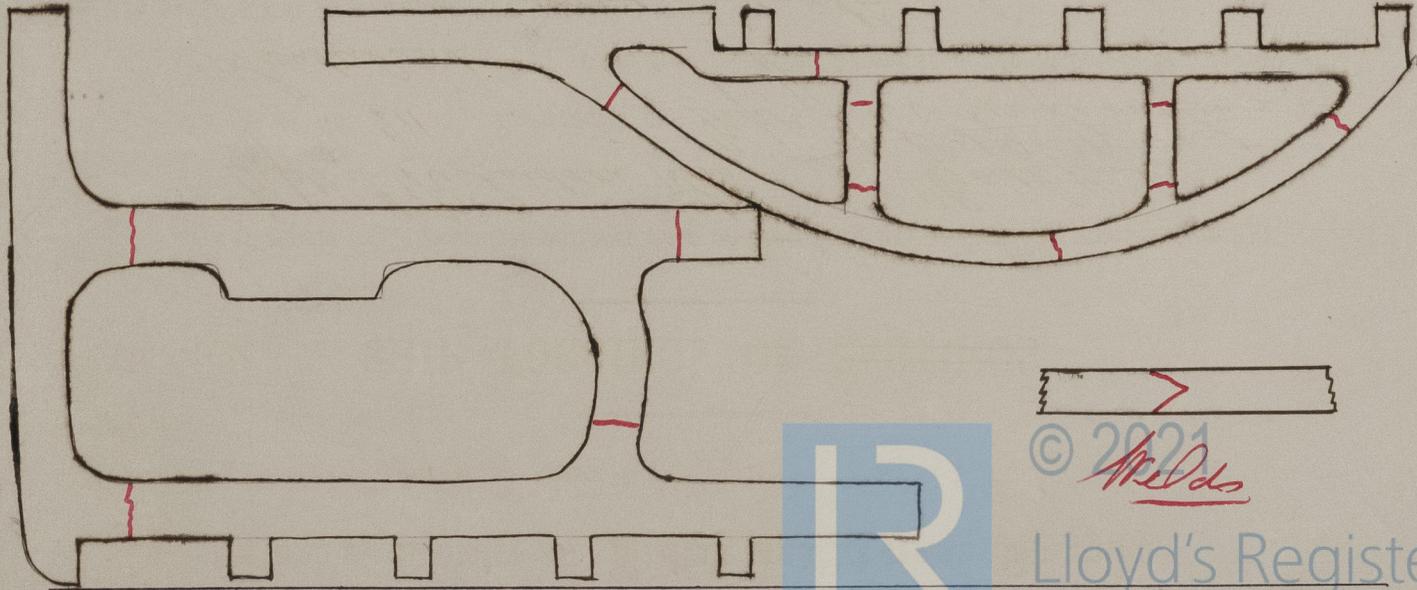

* If of Iron, state whether scrap or puddled Iron.