

Lloyd's Register of British and Foreign Shipping.

(Report on Vessel No. 14,093 Port Sunderland)

No. 328a SHIP FORGINGS OR CASTINGS.

I have to report that the undermentioned Iron or Steel Forgings or Castings, manufactured by Messrs J Richardson & Sons of Northfleet for the Vessel No. 214, being built by Messrs J & R Thompson & Sons of Sunderland have been inspected by me as set forth below, and found to be, so far as can be seen, sound and efficient.


Mark on Forgings.

Lloyd's
No. 328a
H.C.

Hugh Cameron
Sunderland

	STERN FRAME.	RUDDER FRAME.	STEM.
Material* - - - -	<u>Scrap iron</u>	<u>Scrap iron</u>	<u>Scrap iron</u>
How made - - - -	<u>Forged</u>	<u>Forged</u>	<u>Forged</u>
Dimensions - - - -	<u>10' x 6'</u>	<u>4 3/4" - 3 3/4"</u>	<u>10' x 2 3/4'</u>
Progress on Inspection -	<u>Smithed</u>	<u>Forged & Smithed</u>	<u>Forged</u>
Dates when Inspected	<u>July 24 Augt 1-8-10/85</u>	<u>Augt 11-14-22 Sept 3-15</u> <u>14-25 Oct 6-12-26/85</u>	<u>Augt 8-11/85</u>

SKETCHES OF FRAMES SHEWING POSITION AND DESCRIPTION OF WELDS OF FORGINGS, OR PARTICULARS OF TESTS APPLIED TO CASTINGS.

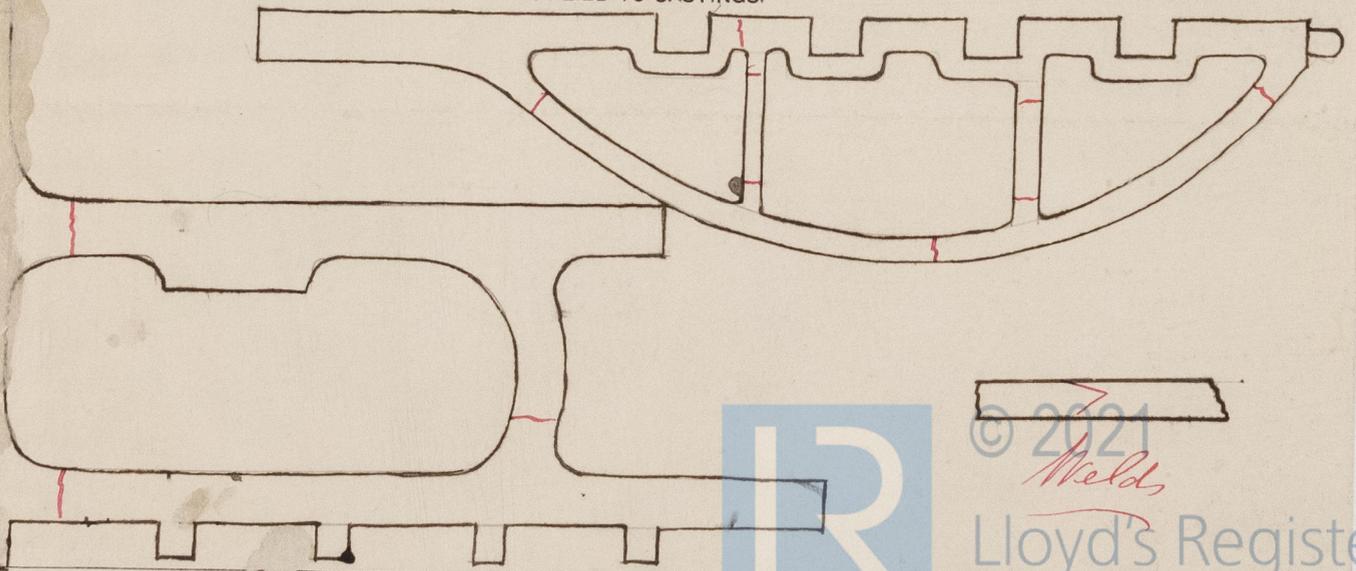

© 2021
Welds

Lloyd's Register
Foundation

* If of Iron, state whether scrap or puddled Iron.