


Atk. to Sld. 7/9/86

S.S. Federation Sld. report No. 14.105.

— S. S. No. 156 —  
— Arrangement of Ballast —  
— Tank Suctions —

S. P. AUSTIN & SON  
21 Sept 86  
IRON & STEEL SHIPBUILDERS  
REPAIRERS  
SUNDERLAND  
W. Macdonald

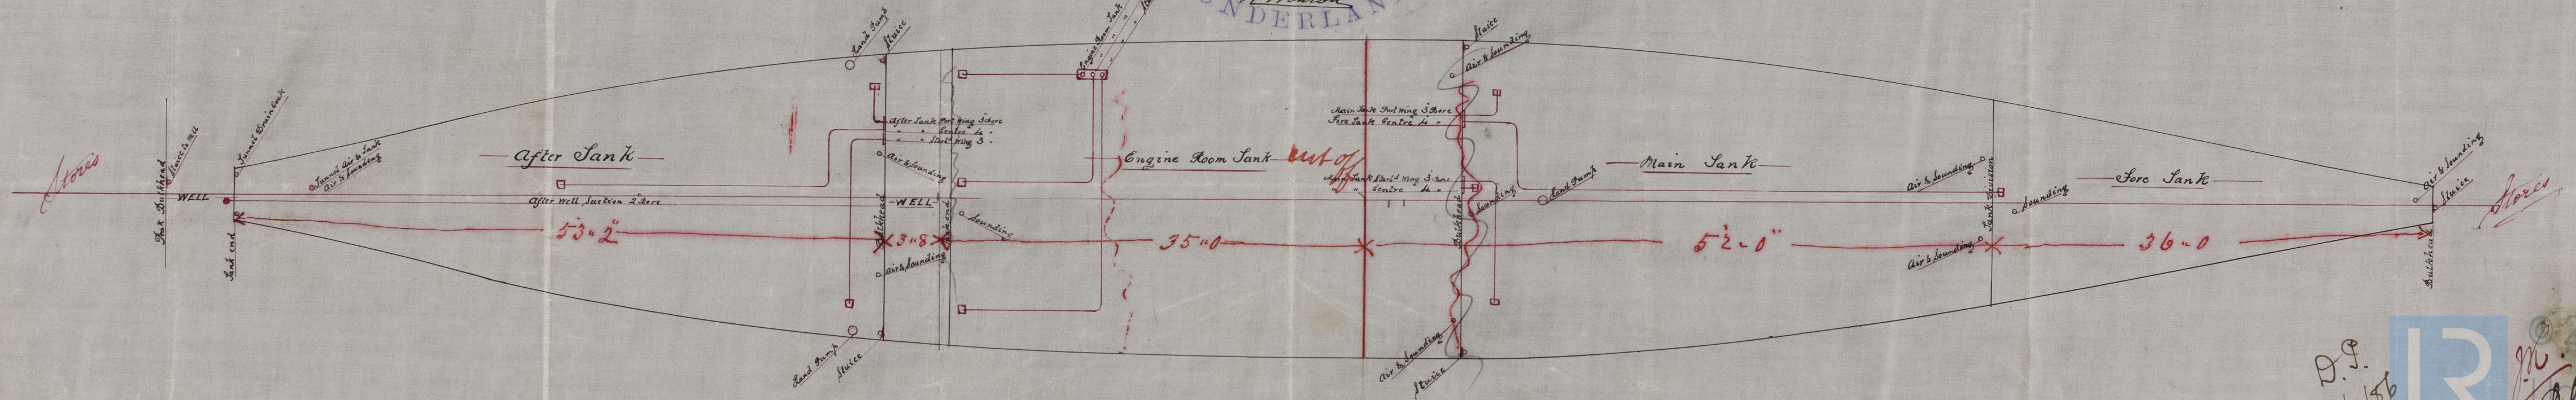

D.S.  
7/9/86



4/9/86  
14-9-86  
Lloyd's Register  
Foundation

SLD 953-0053