

The words FORGINGS or CASTINGS, IRON or STEEL, should be struck out as may be required.

Received at

Office,

26

# Lloyd's Register of British and Foreign Shipping.

(Report on Vessel No. *14,105* Port *Sunderland*)

No. *441A*.

## SHIP FORGINGS OR CASTINGS.

I have to report that the undermentioned Iron or Steel Forgings or Castings, manufactured by *Messrs Reay & Wether* of *Hylton* for the Vessel No. *156*, being built by *Messrs J P Austin & Son* of *Sunderland*, have been inspected by me as set forth below, and found to be, so far as can be seen, *sound*.

Mark on Forgings.

Lloyd's

No. *441A*


*R.C.*

*Hugh Cameron*

*Sunderland*

	STERN FRAME.	RUDDER FRAME.	STEM.
Material* - - - -	<i>Scrap Iron</i>	<i>Scrap Iron</i>	<i>Scrap Iron</i>
How made - - - -	<i>Forged</i>	<i>Forged</i>	<i>Forged</i>
Dimensions - - - -	<i>7" x 14 3/4"</i>	<i>5 1/4" - 3"</i>	<i>7" x 2 1/8"</i>
Progress on Inspection -	<i>Forged &amp; Smithed</i>	<i>Forged &amp; Smithed</i>	<i>Forged</i>
Dates when Inspected	<i>May 19. 24-28-31/86</i>	<i>May 28-31 June 4-17/86</i>	<i>May 19/86</i>

SKETCHES OF FRAMES SHEWING POSITION AND DESCRIPTION OF WELDS OF FORGINGS, OR PARTICULARS OF TESTS APPLIED TO CASTINGS.

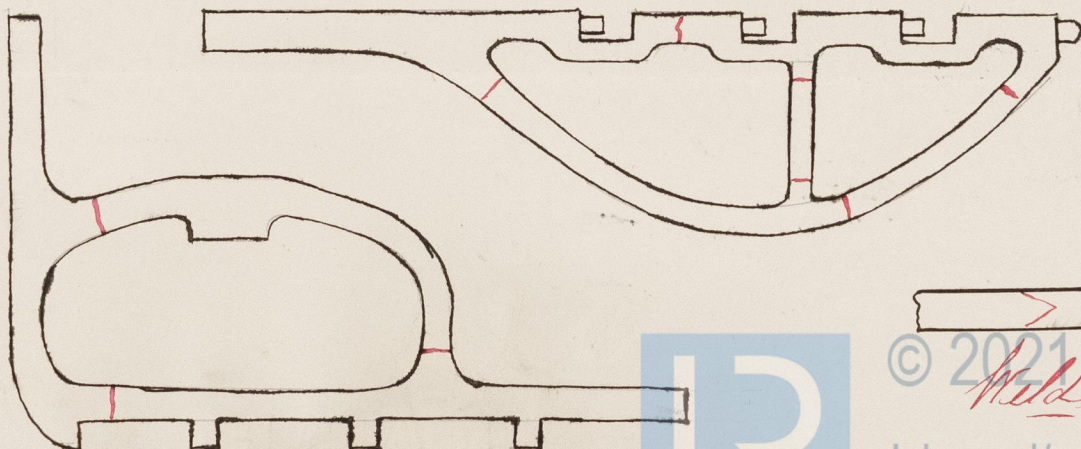

© 2021

*Mills*

Lloyd's Register  
Foundation