

TRACING 6143

Approved.  
23/5/01

Sunderland S. B. Co<sup>2</sup> "Galatea"  
V. S. No 141




N. Allison  
21.5.87

Plates  $1\frac{1}{2}$ "  
Rivets  $1\frac{1}{2}$ "  
Pitch  $4\frac{3}{4}$ "

Working Pressure 150 lbs  
Test " 300 "

$$\text{Working Pressure} = \frac{260 \times 1.0625 \times 44.6}{141.845} = 151 \text{ lbs}$$

Plates, rivets & Nails to be made of Steel  
Tubes & girders " " " Wrought iron

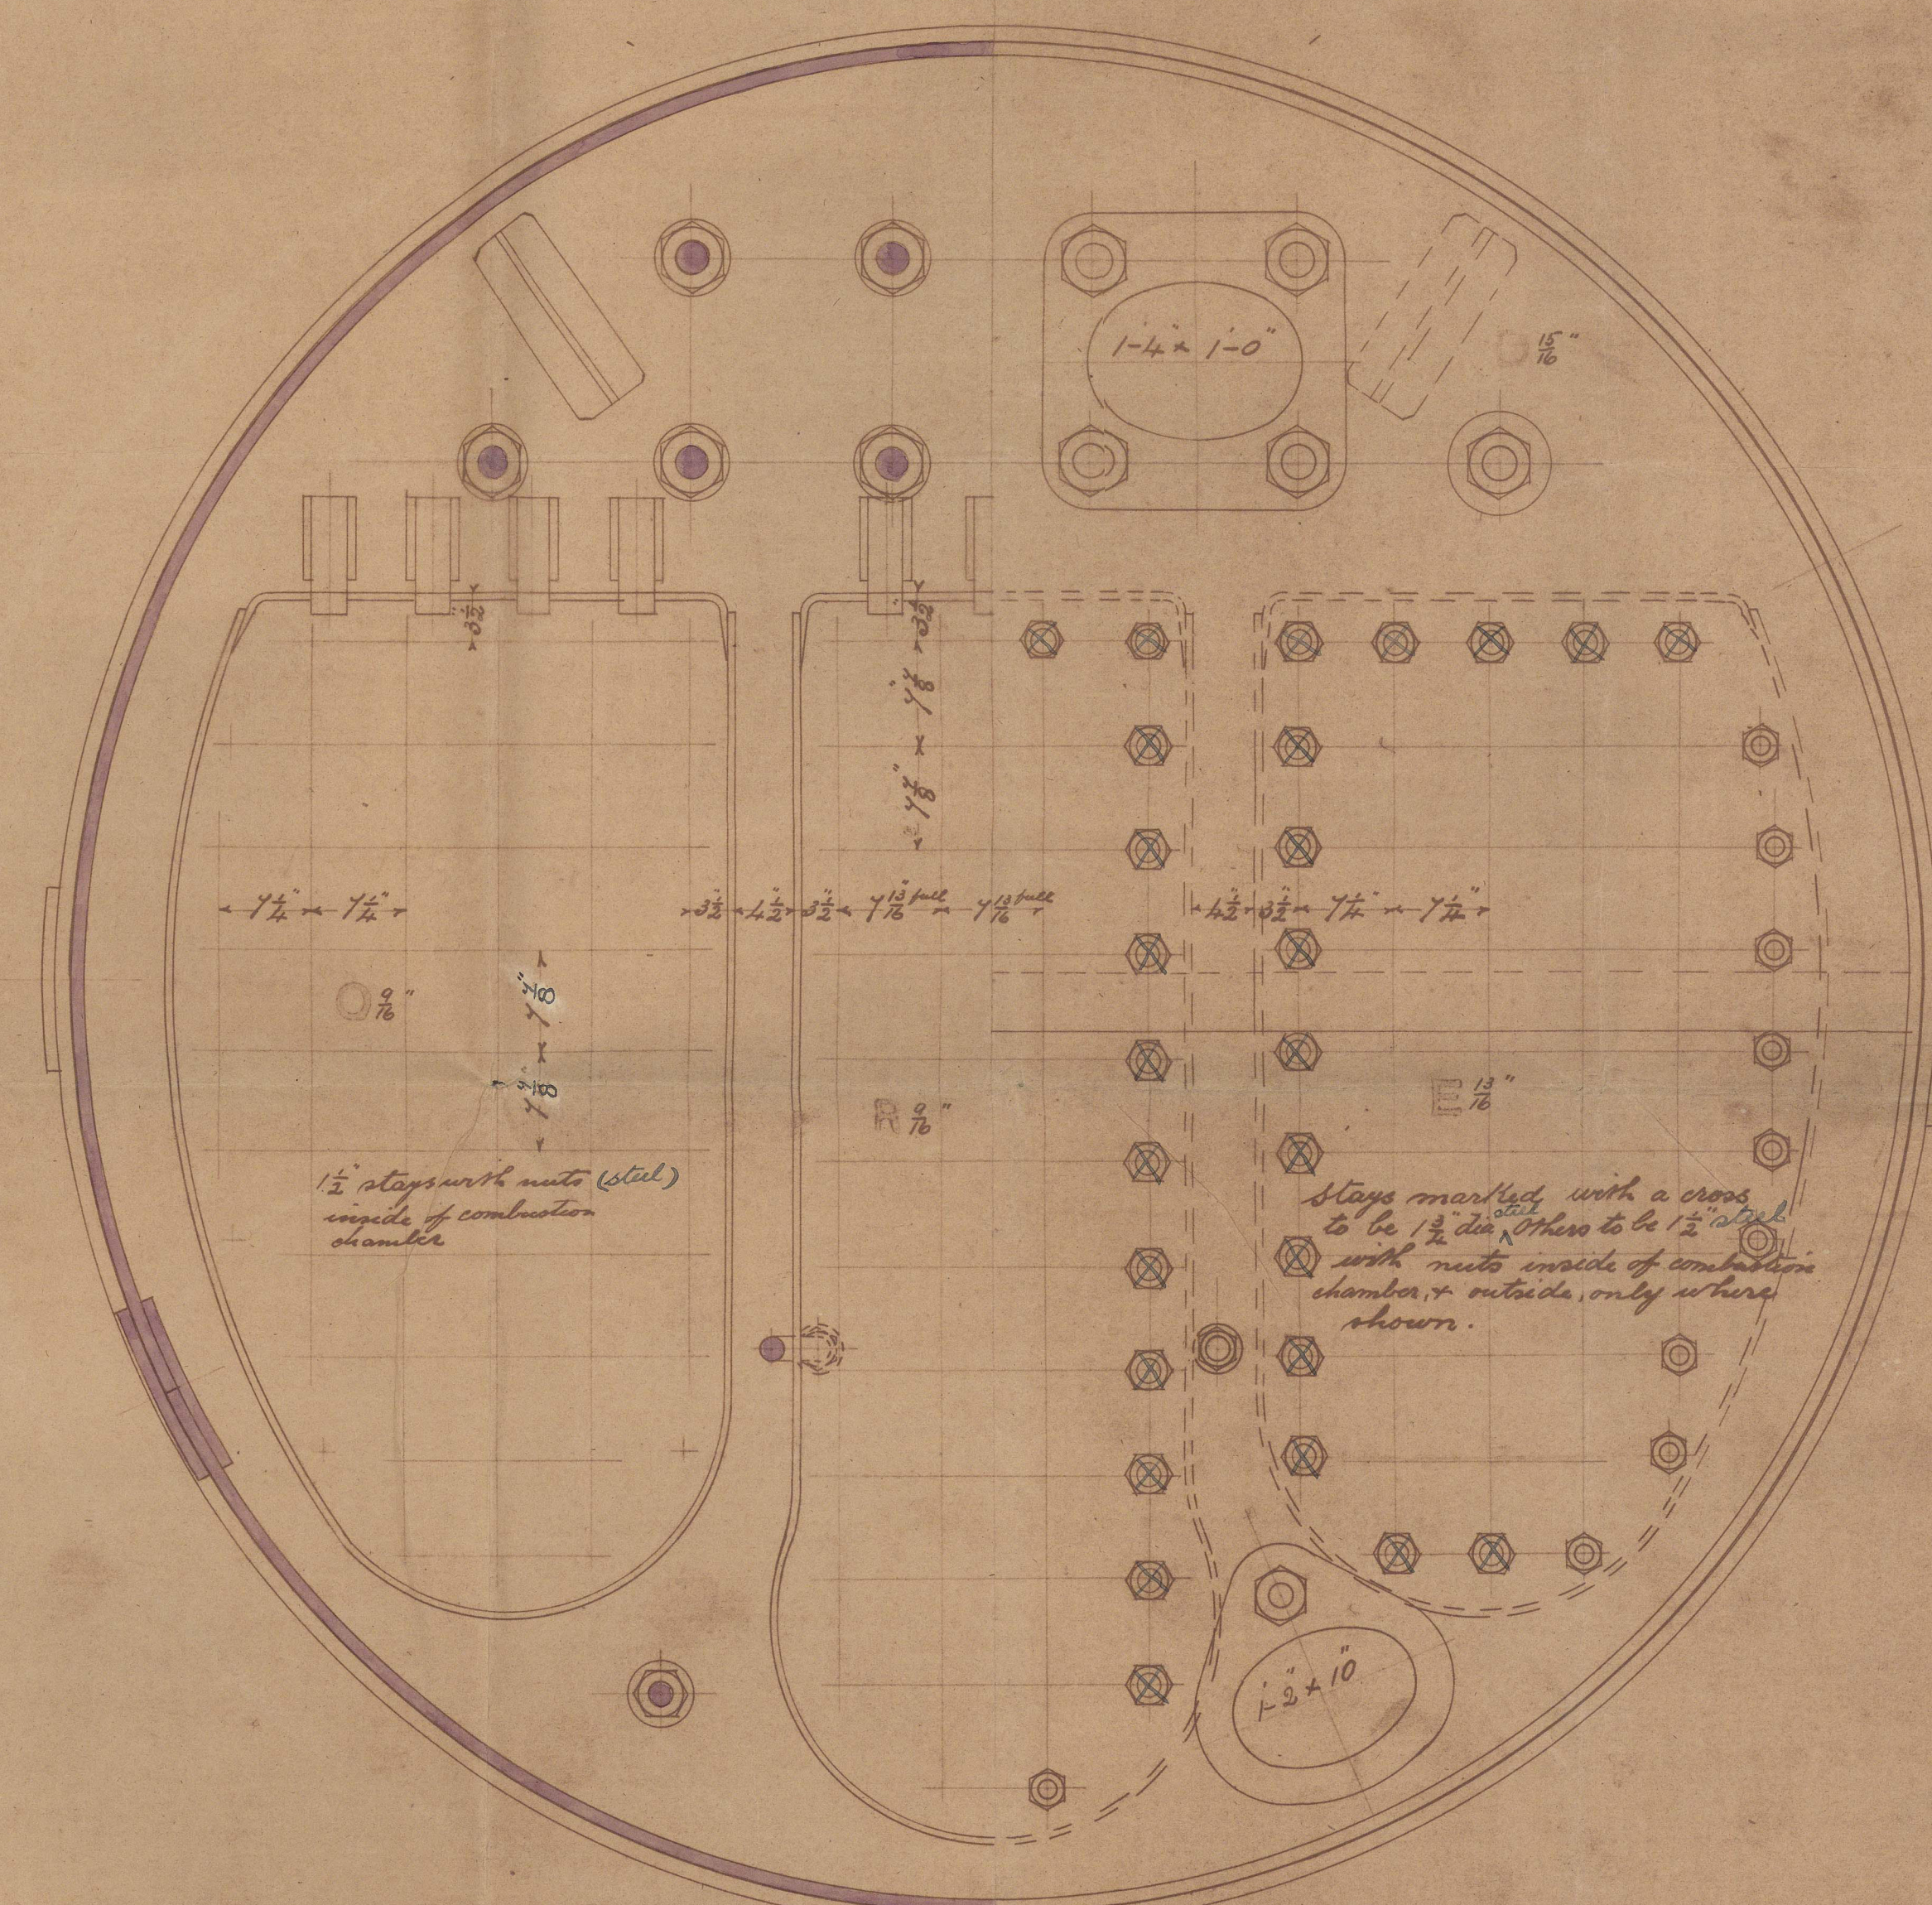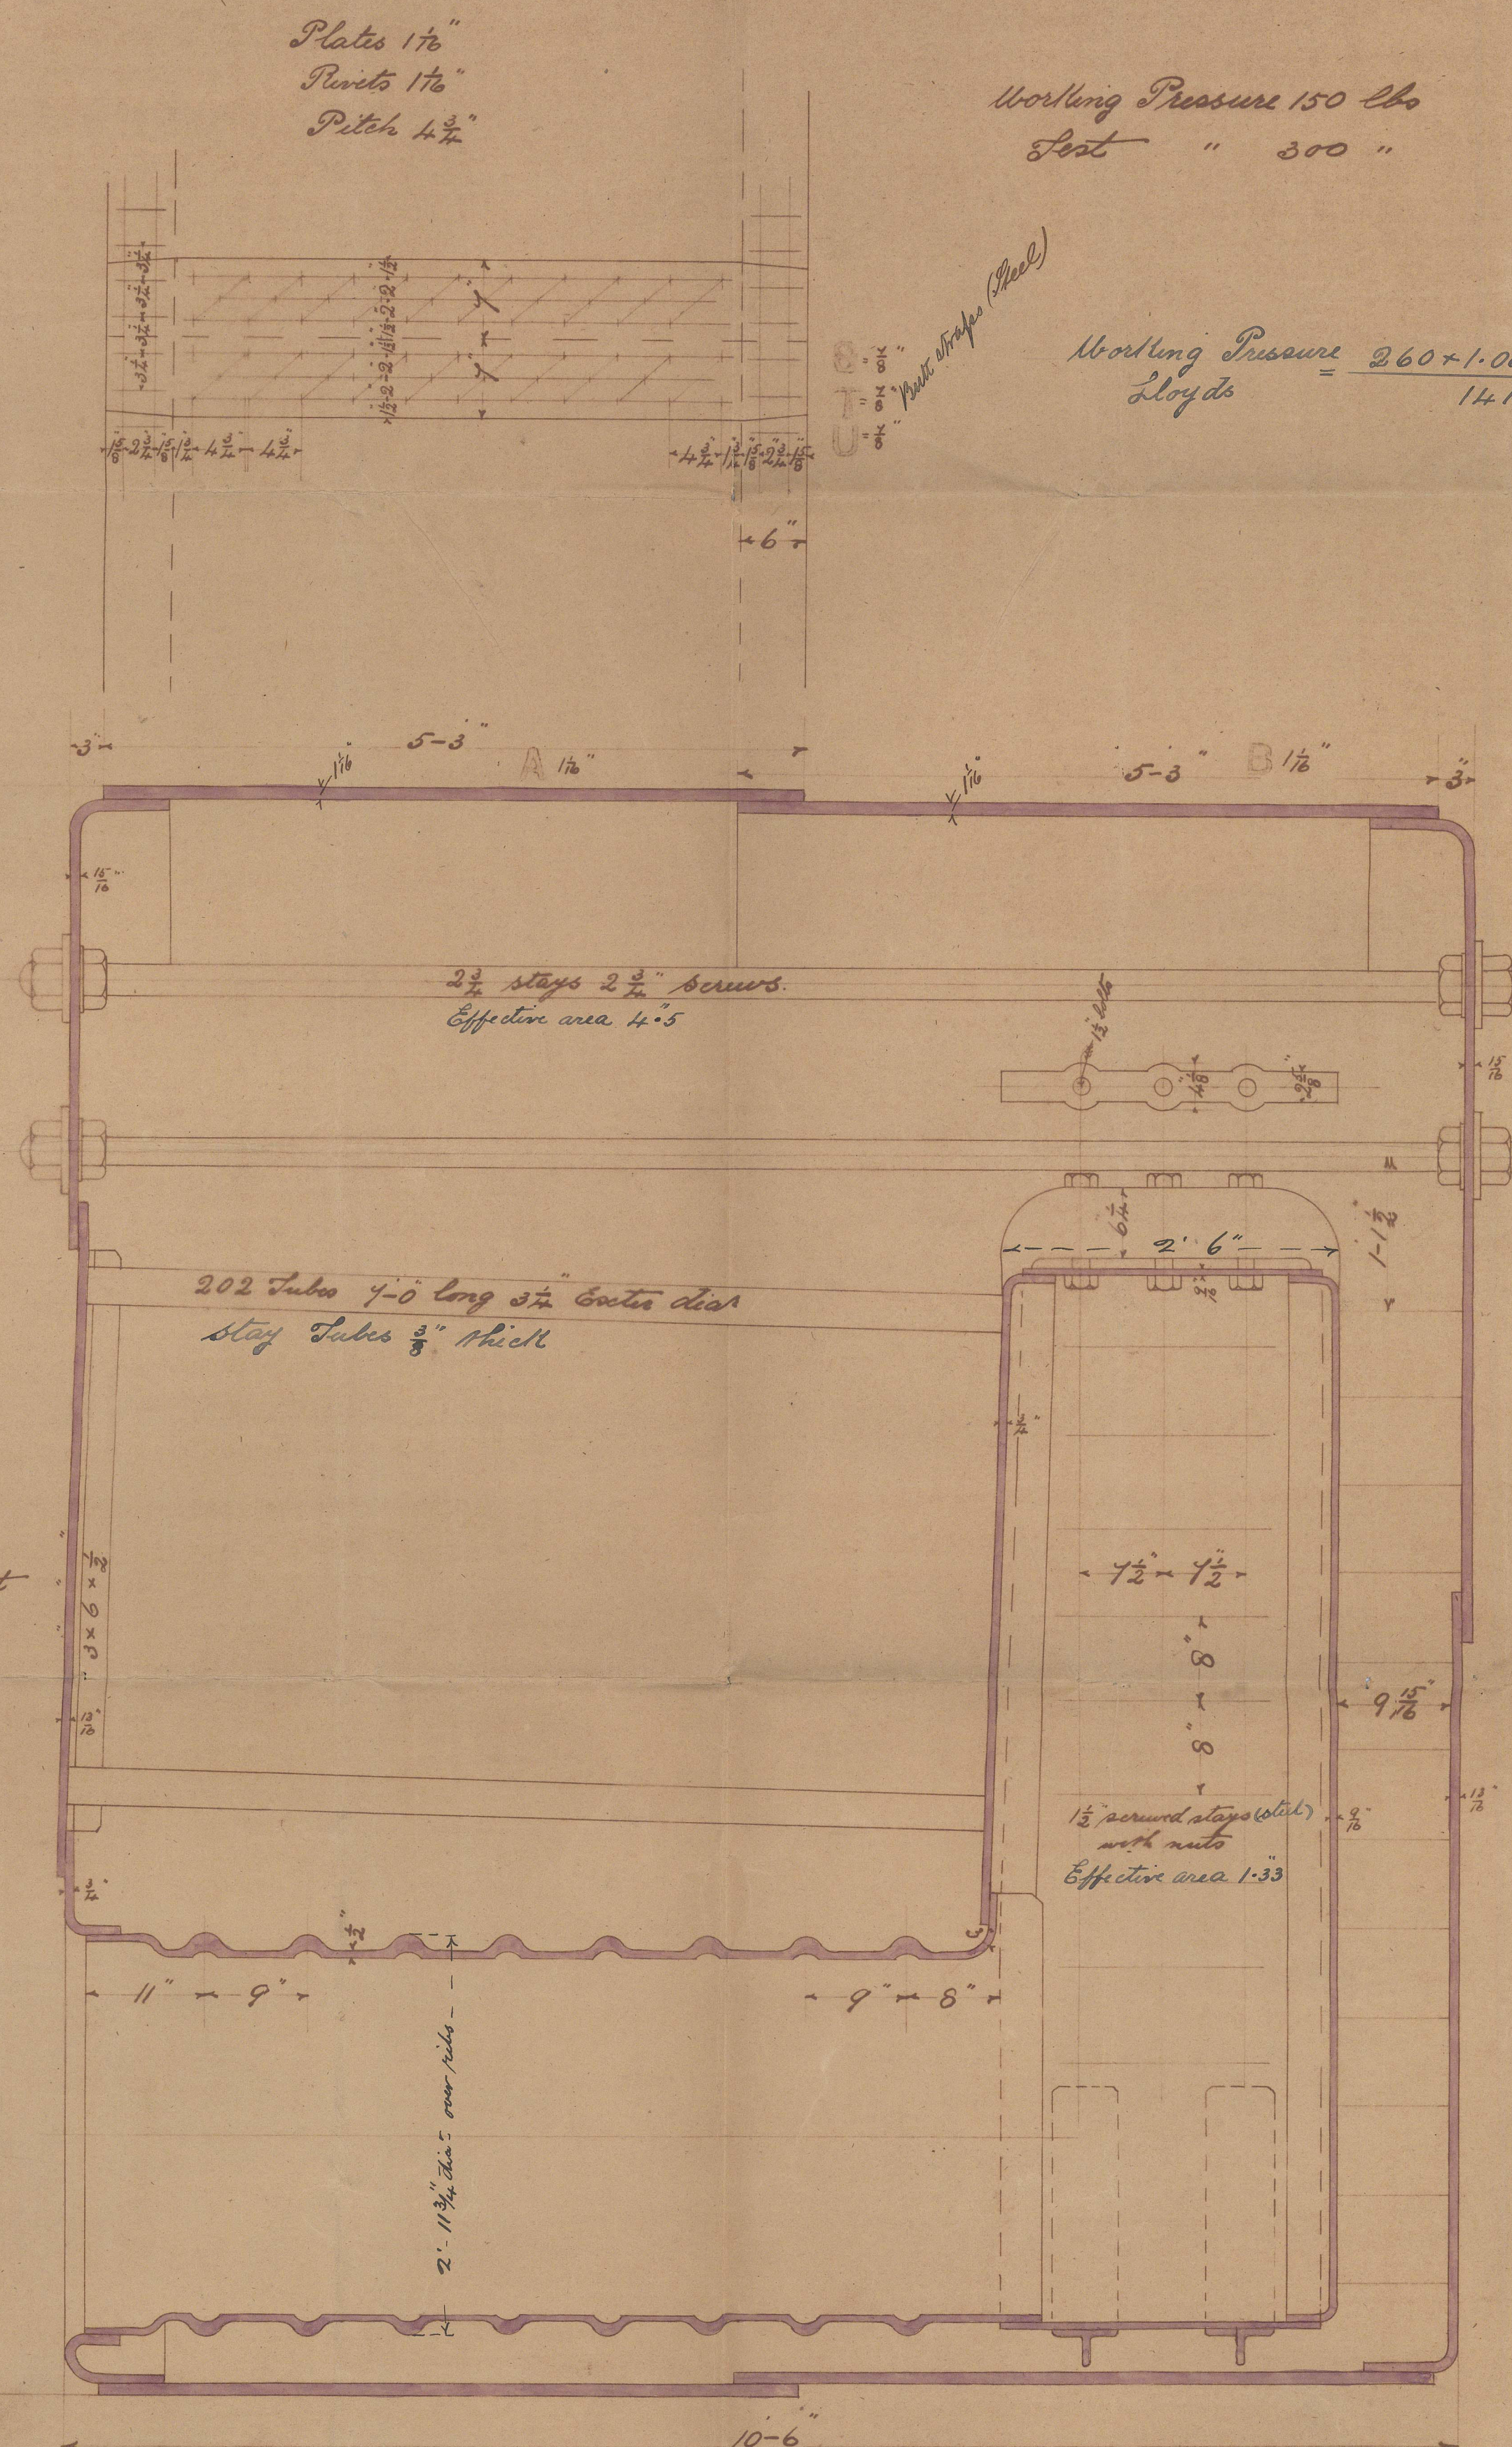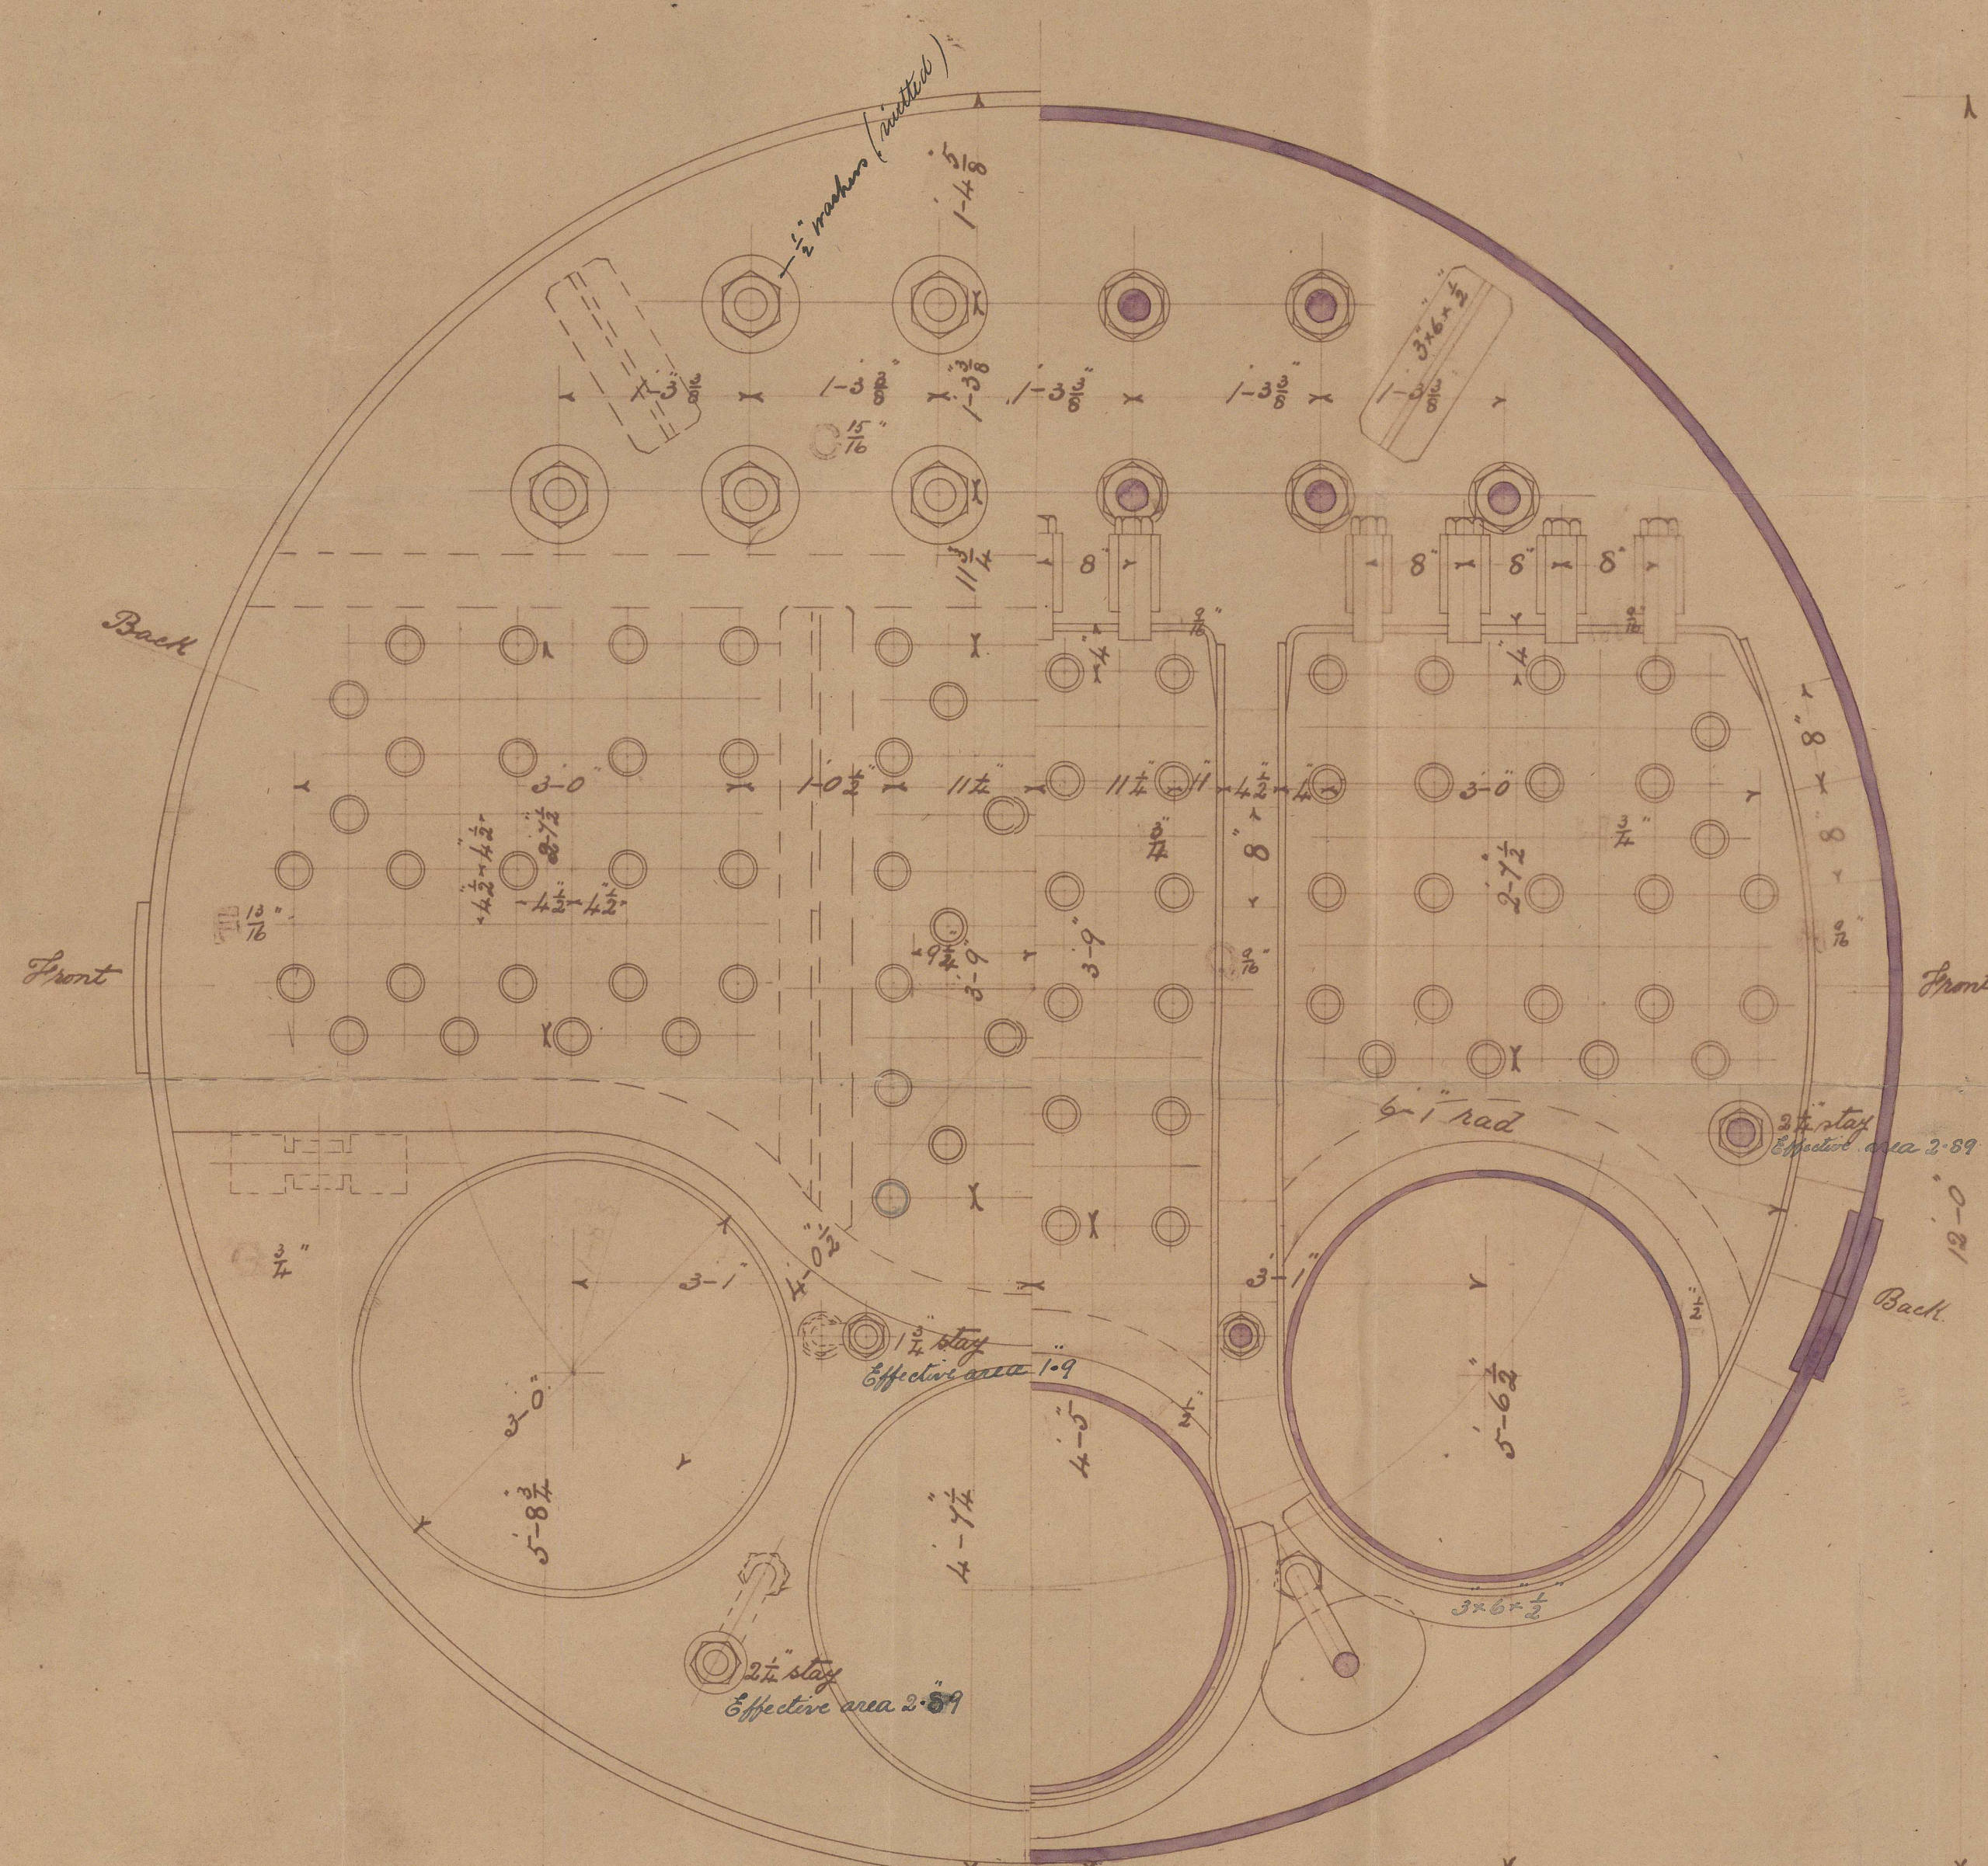

22  
28.5.77

CONTRACT 359





S. S. Galatea



© 2021

Lloyd's Register  
Foundation