


S.S. Galatea Sld. report no. 14390

9.5.87.
15.8.87.

28 $\frac{1}{2}$ "
1887-1888

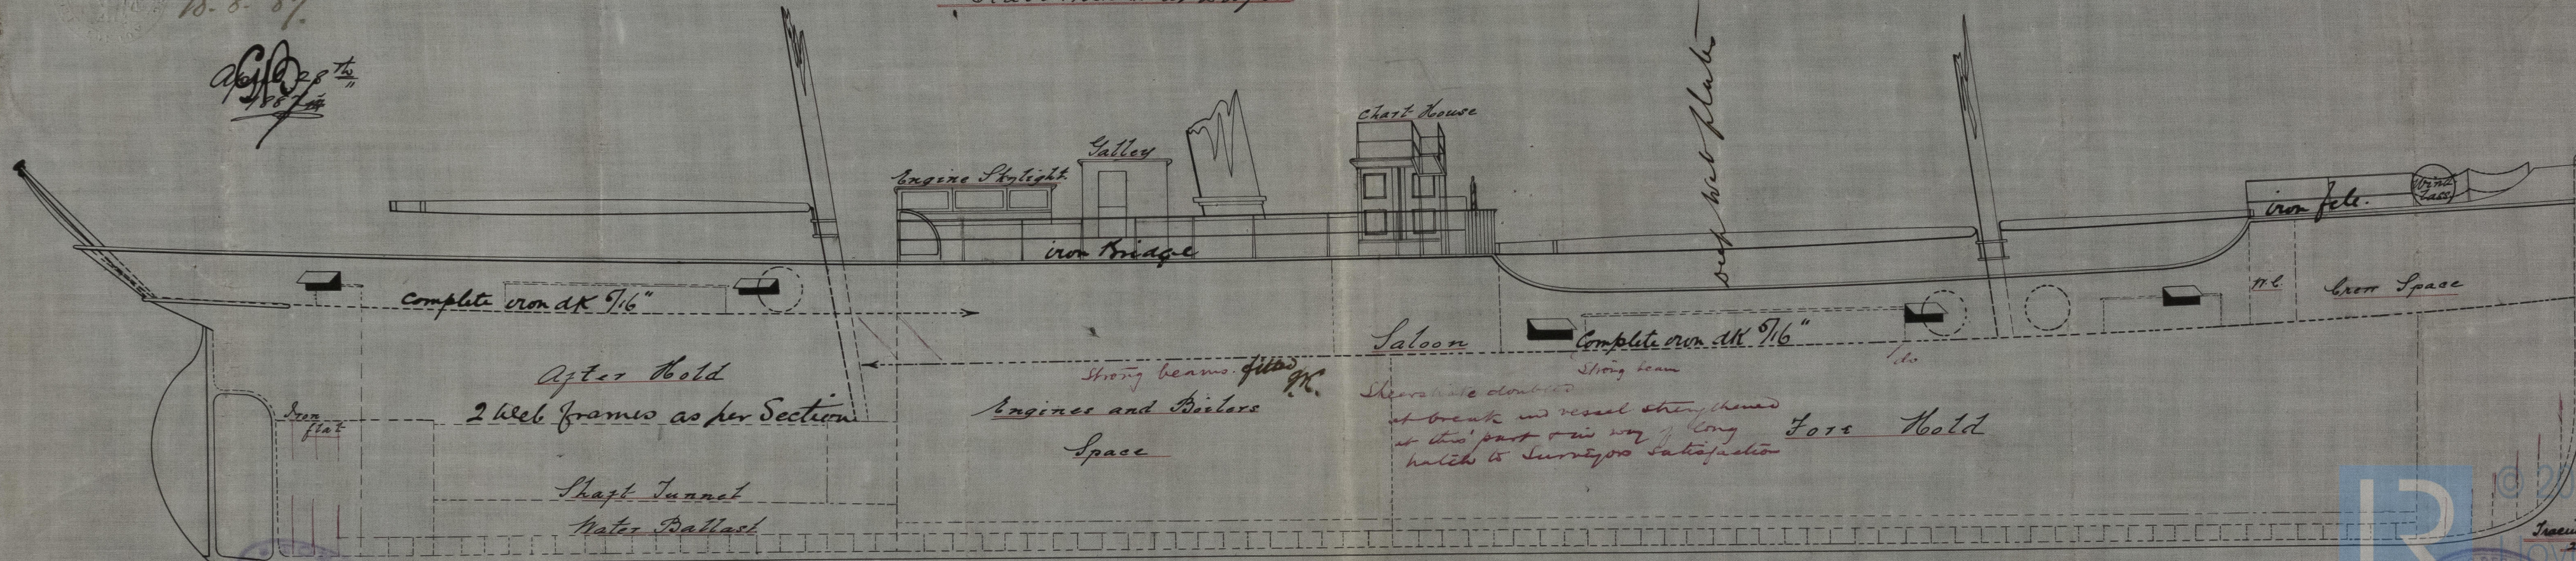

Tracing No 28/14
28/5/87

2015/187


SLD955-0078


S.S. Galatia Sld. No. 14390. 78.8.7.



W. J. ...

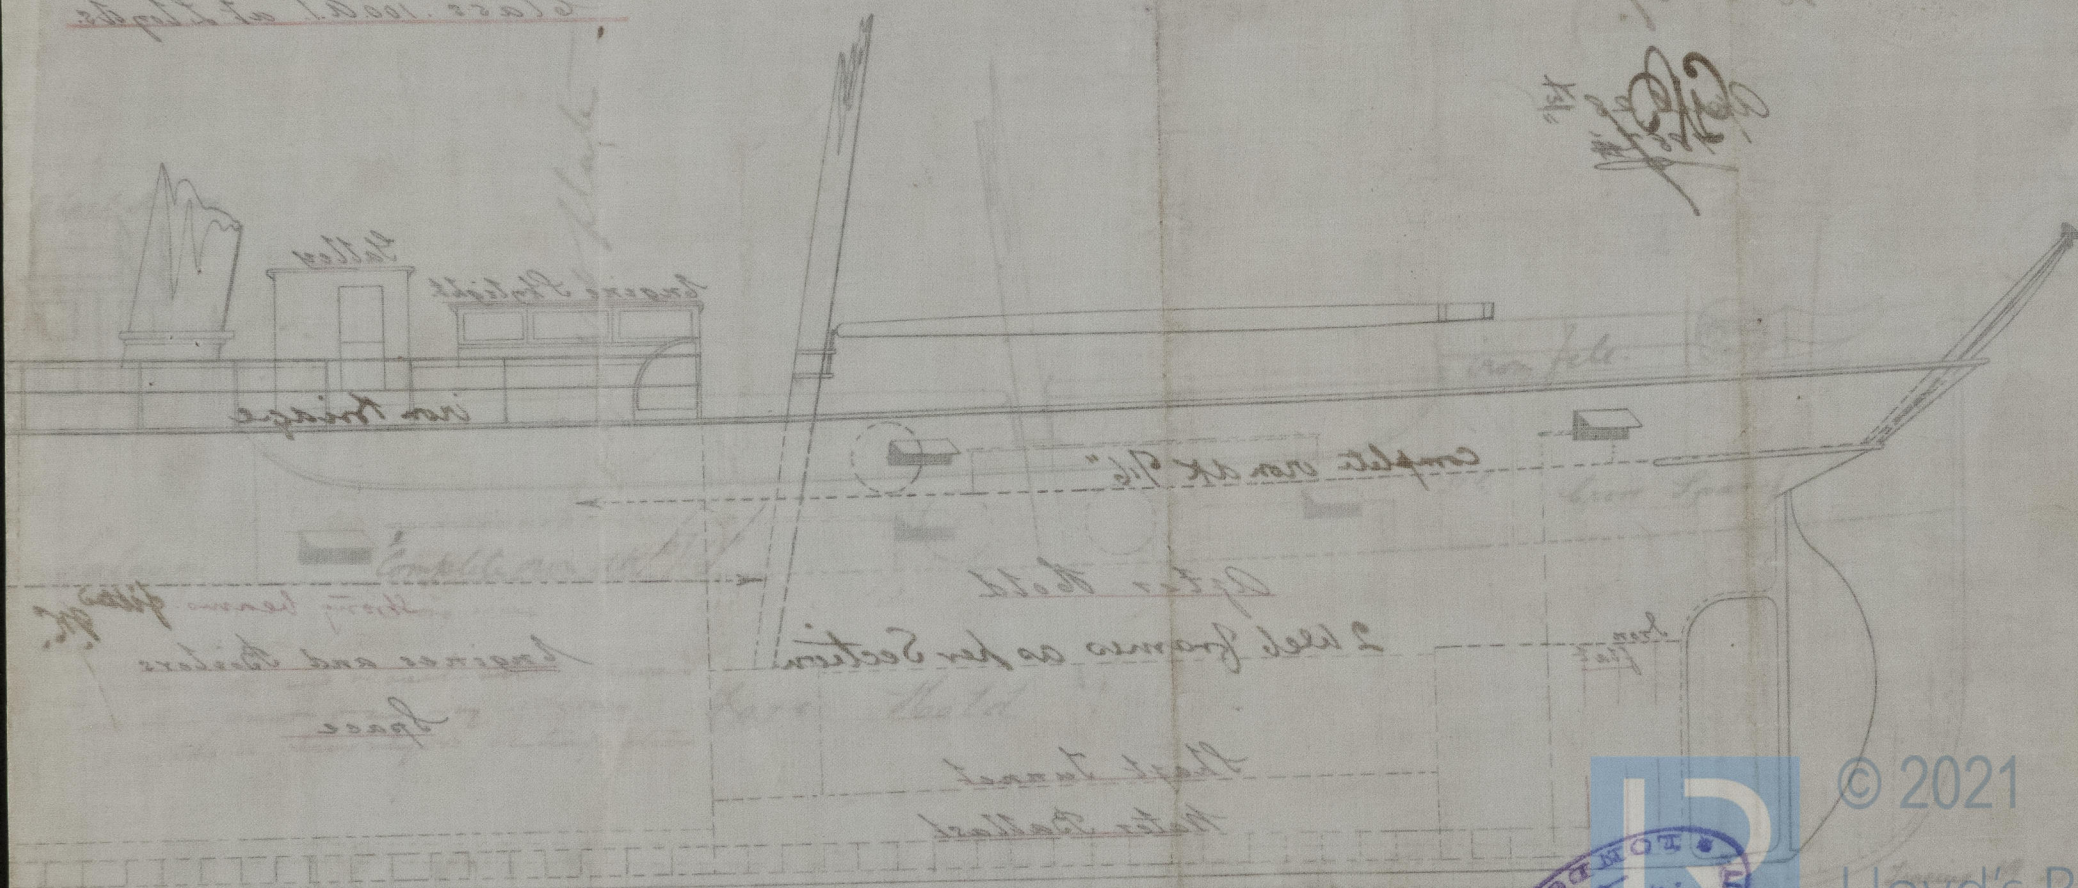

© 2021
 Lloyd's Register
 Foundation

8400-0078