

S. S. Galatea / Eld. report No. 14390

9.5.87.

Midship Section

Length B.P. 170'0"

Breadth B. 27'0"



Depth Mtd. 13'1 1/2" Floors 12'1 1/2"

Class 100. A.

Scale 1/2" = 1 Foot

No. 1441

Iron.

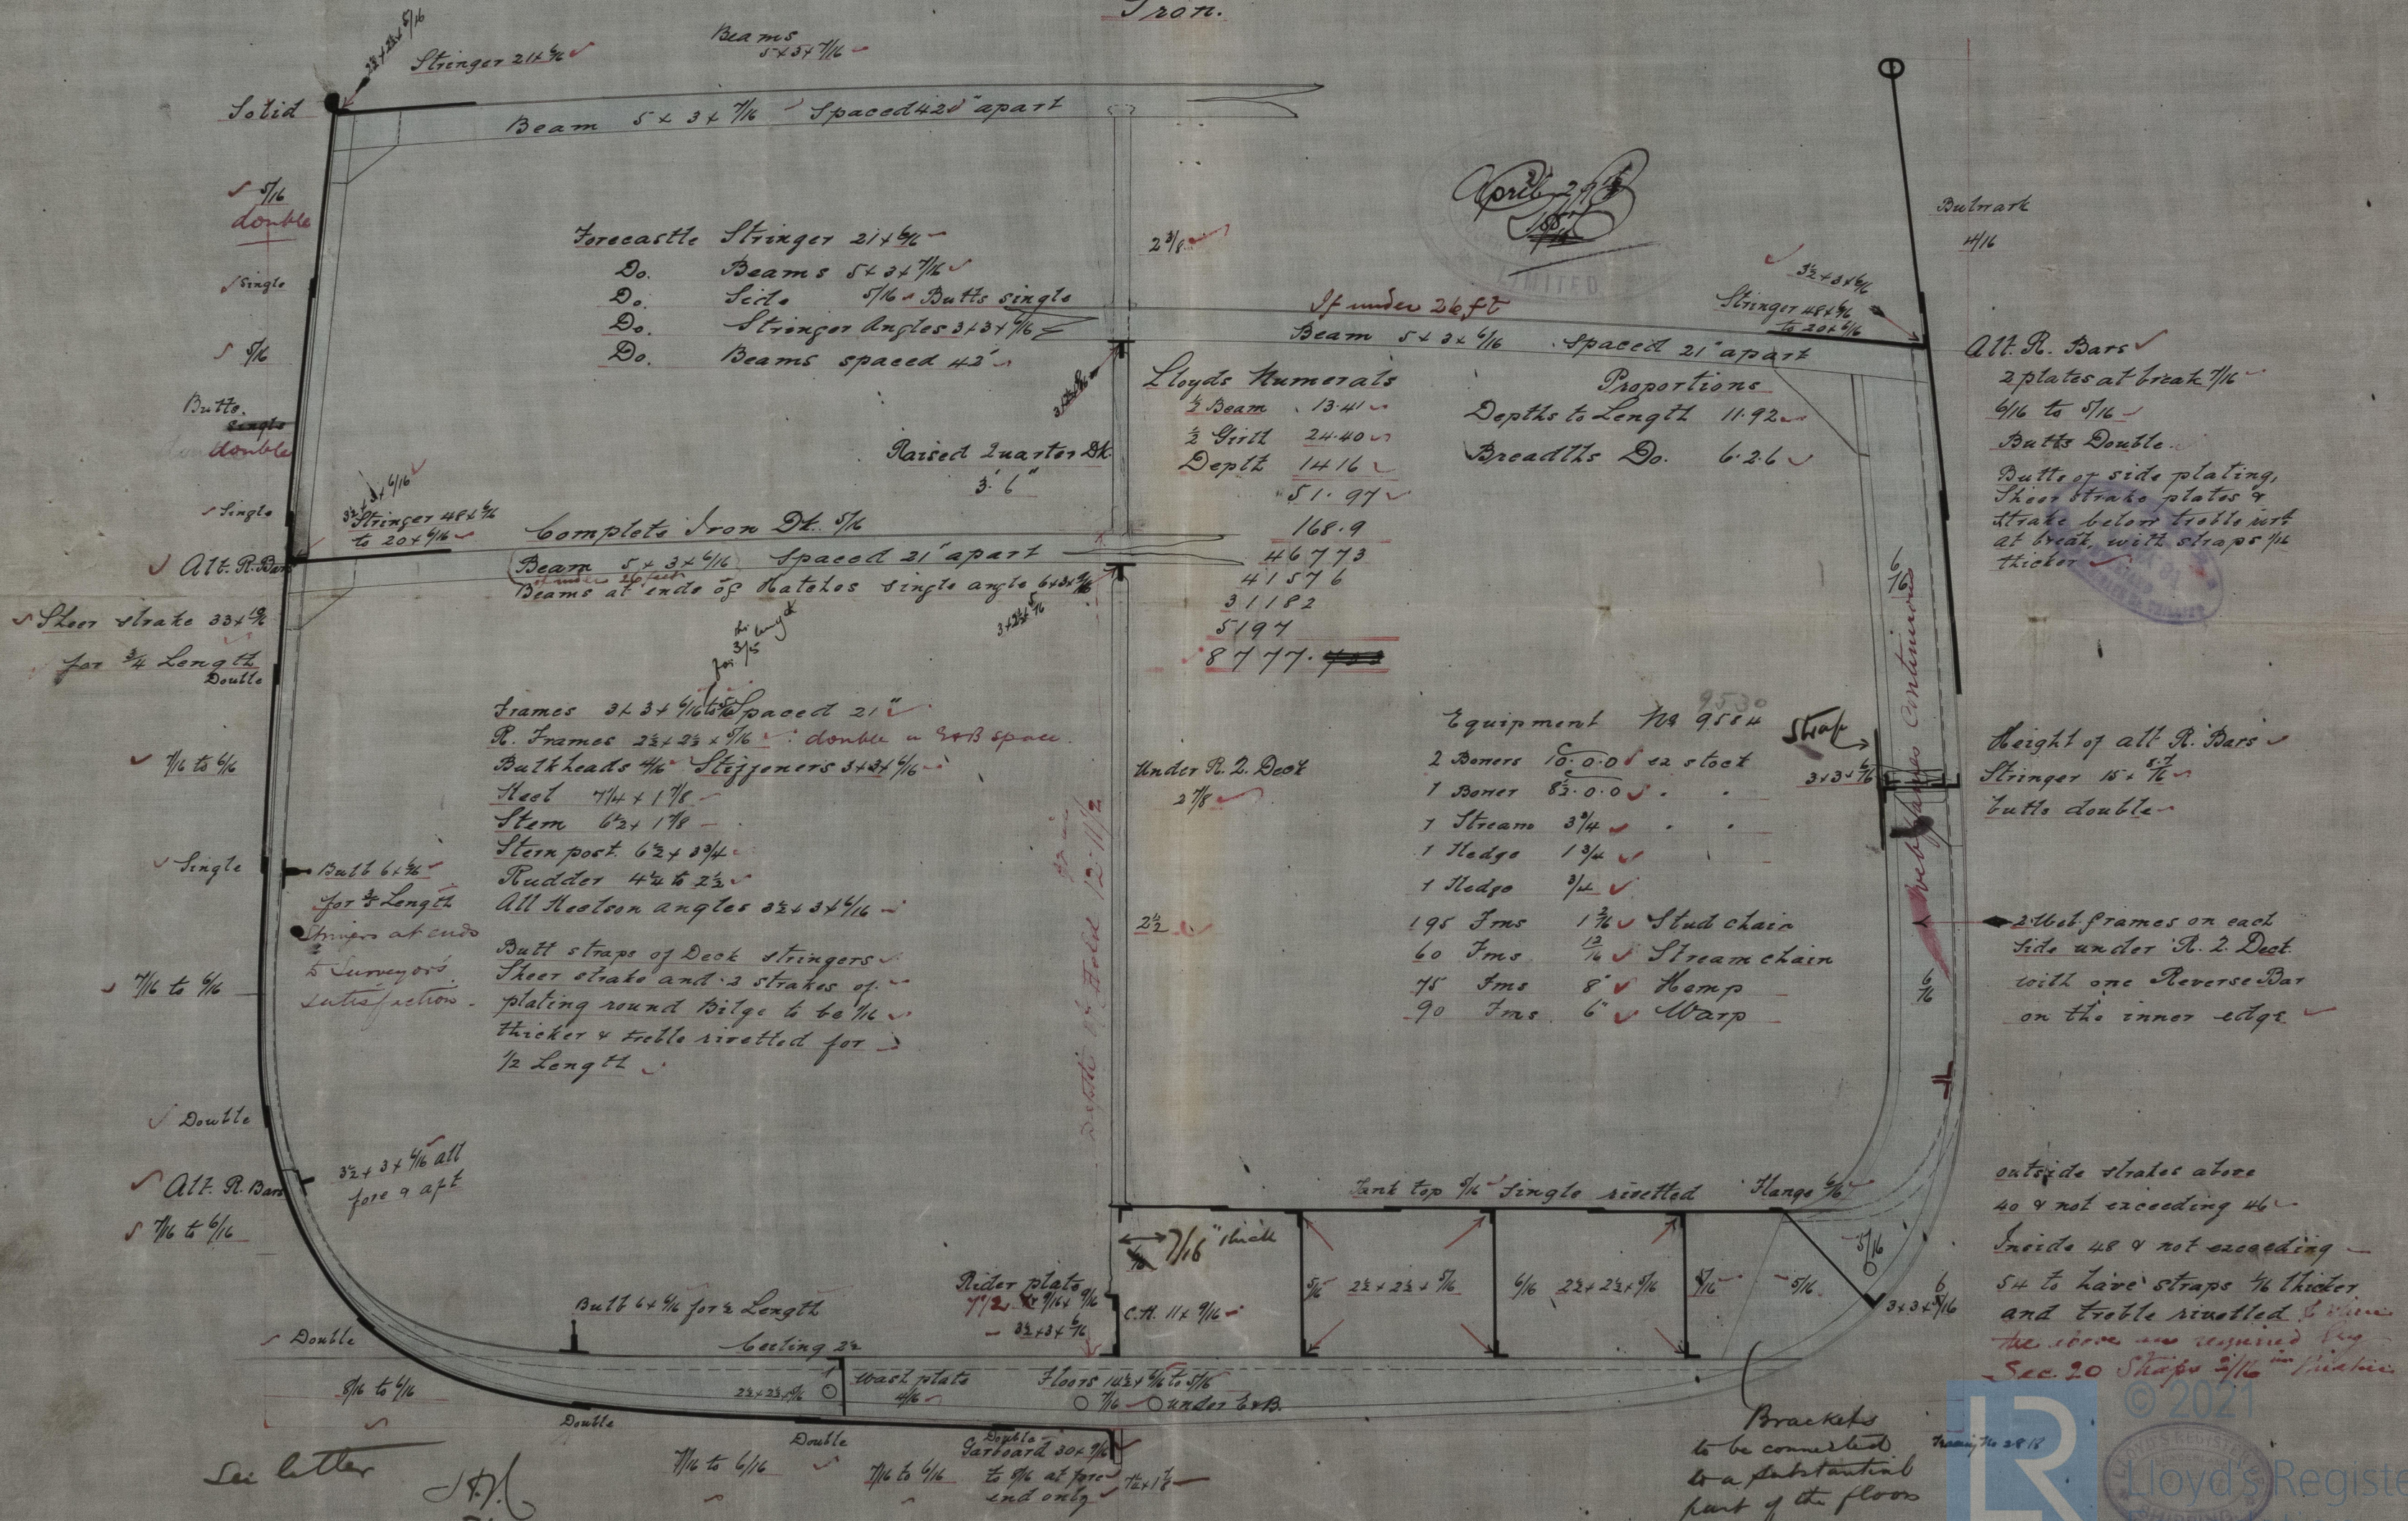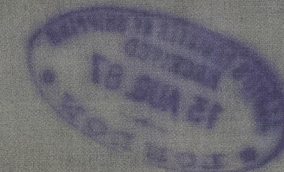

See letter

14/6  
7/5/87

SLD955-0079



