

The words FORGINGS or CASTINGS, IRON or STEEL, should be struck out as may be required.

Smith

Lloyd's Register of British and Foreign Shipping.

(Report on Vessel No. 14393 Port Sunderland)

No. 626a

SHIP FORGINGS OR CASTINGS.

I have to report that the undermentioned Iron or Steel Forgings or Castings, manufactured by Messrs Birnbridge Co. of Pallin for the Vessel No. 141, being built by Messrs the Sunderland S.S. Co. of Sunderland have been inspected by me as set forth below, and found to be, so far as can be seen, sound.


Mark on Forgings.

Lloyd's
No. 626a
16 G

Hugh Cannon
Sunderland
3/8/84

	STERN FRAME.	RUDDER FRAME.	STEM.
Material*	<i>Scrap iron</i>	<i>Scrap iron</i>	<i>Scrap iron</i>
How made	<i>Forged</i>	<i>Forged</i>	<i>Forged</i>
Dimensions	<i>6 1/2 x 5 3/4</i>	<i>4 1/4 - 2 1/2</i>	<i>6 1/2 x 1 7/8</i>
Progress on Inspection	<i>Forged Smithed</i>	<i>Forged Smithed</i>	<i>Forged</i>
Dates when Inspected	<i>May 24-26-28 June 4/84</i>	<i>May 28 June 4-22 July 20/84</i>	<i>May 24/84</i>

SKETCHES OF FRAMES SHEWING POSITION AND DESCRIPTION OF WELDS OF FORGINGS, OR PARTICULARS OF TESTS APPLIED TO CASTINGS.

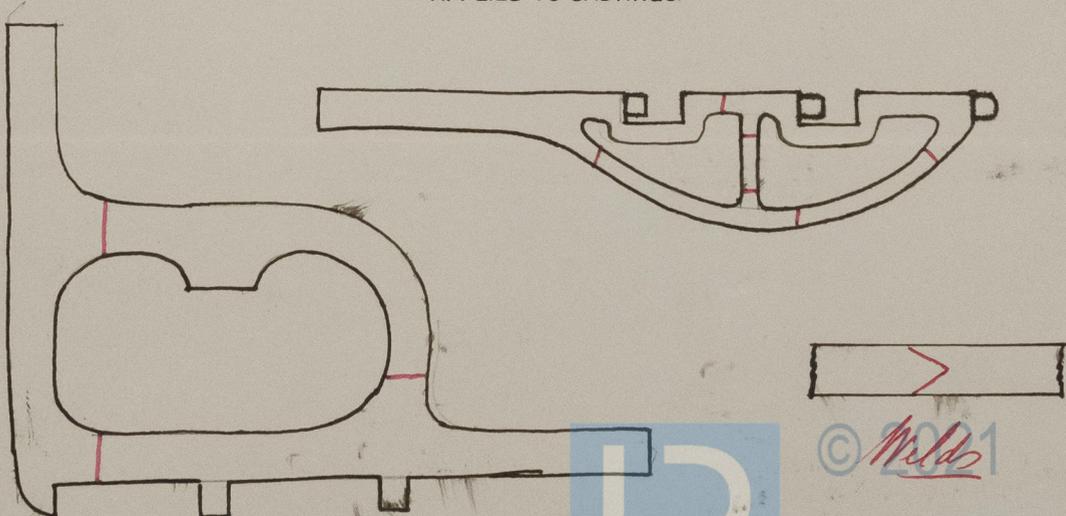

© *Welds* 2011



Lloyd's Register
Foundation

626