


10.2.87.  
19.2.87.

# STEEL SCREW STEAMER "MURRUMBIDGE" N° 228

Sunderland 14437

27 No  
19.6.89

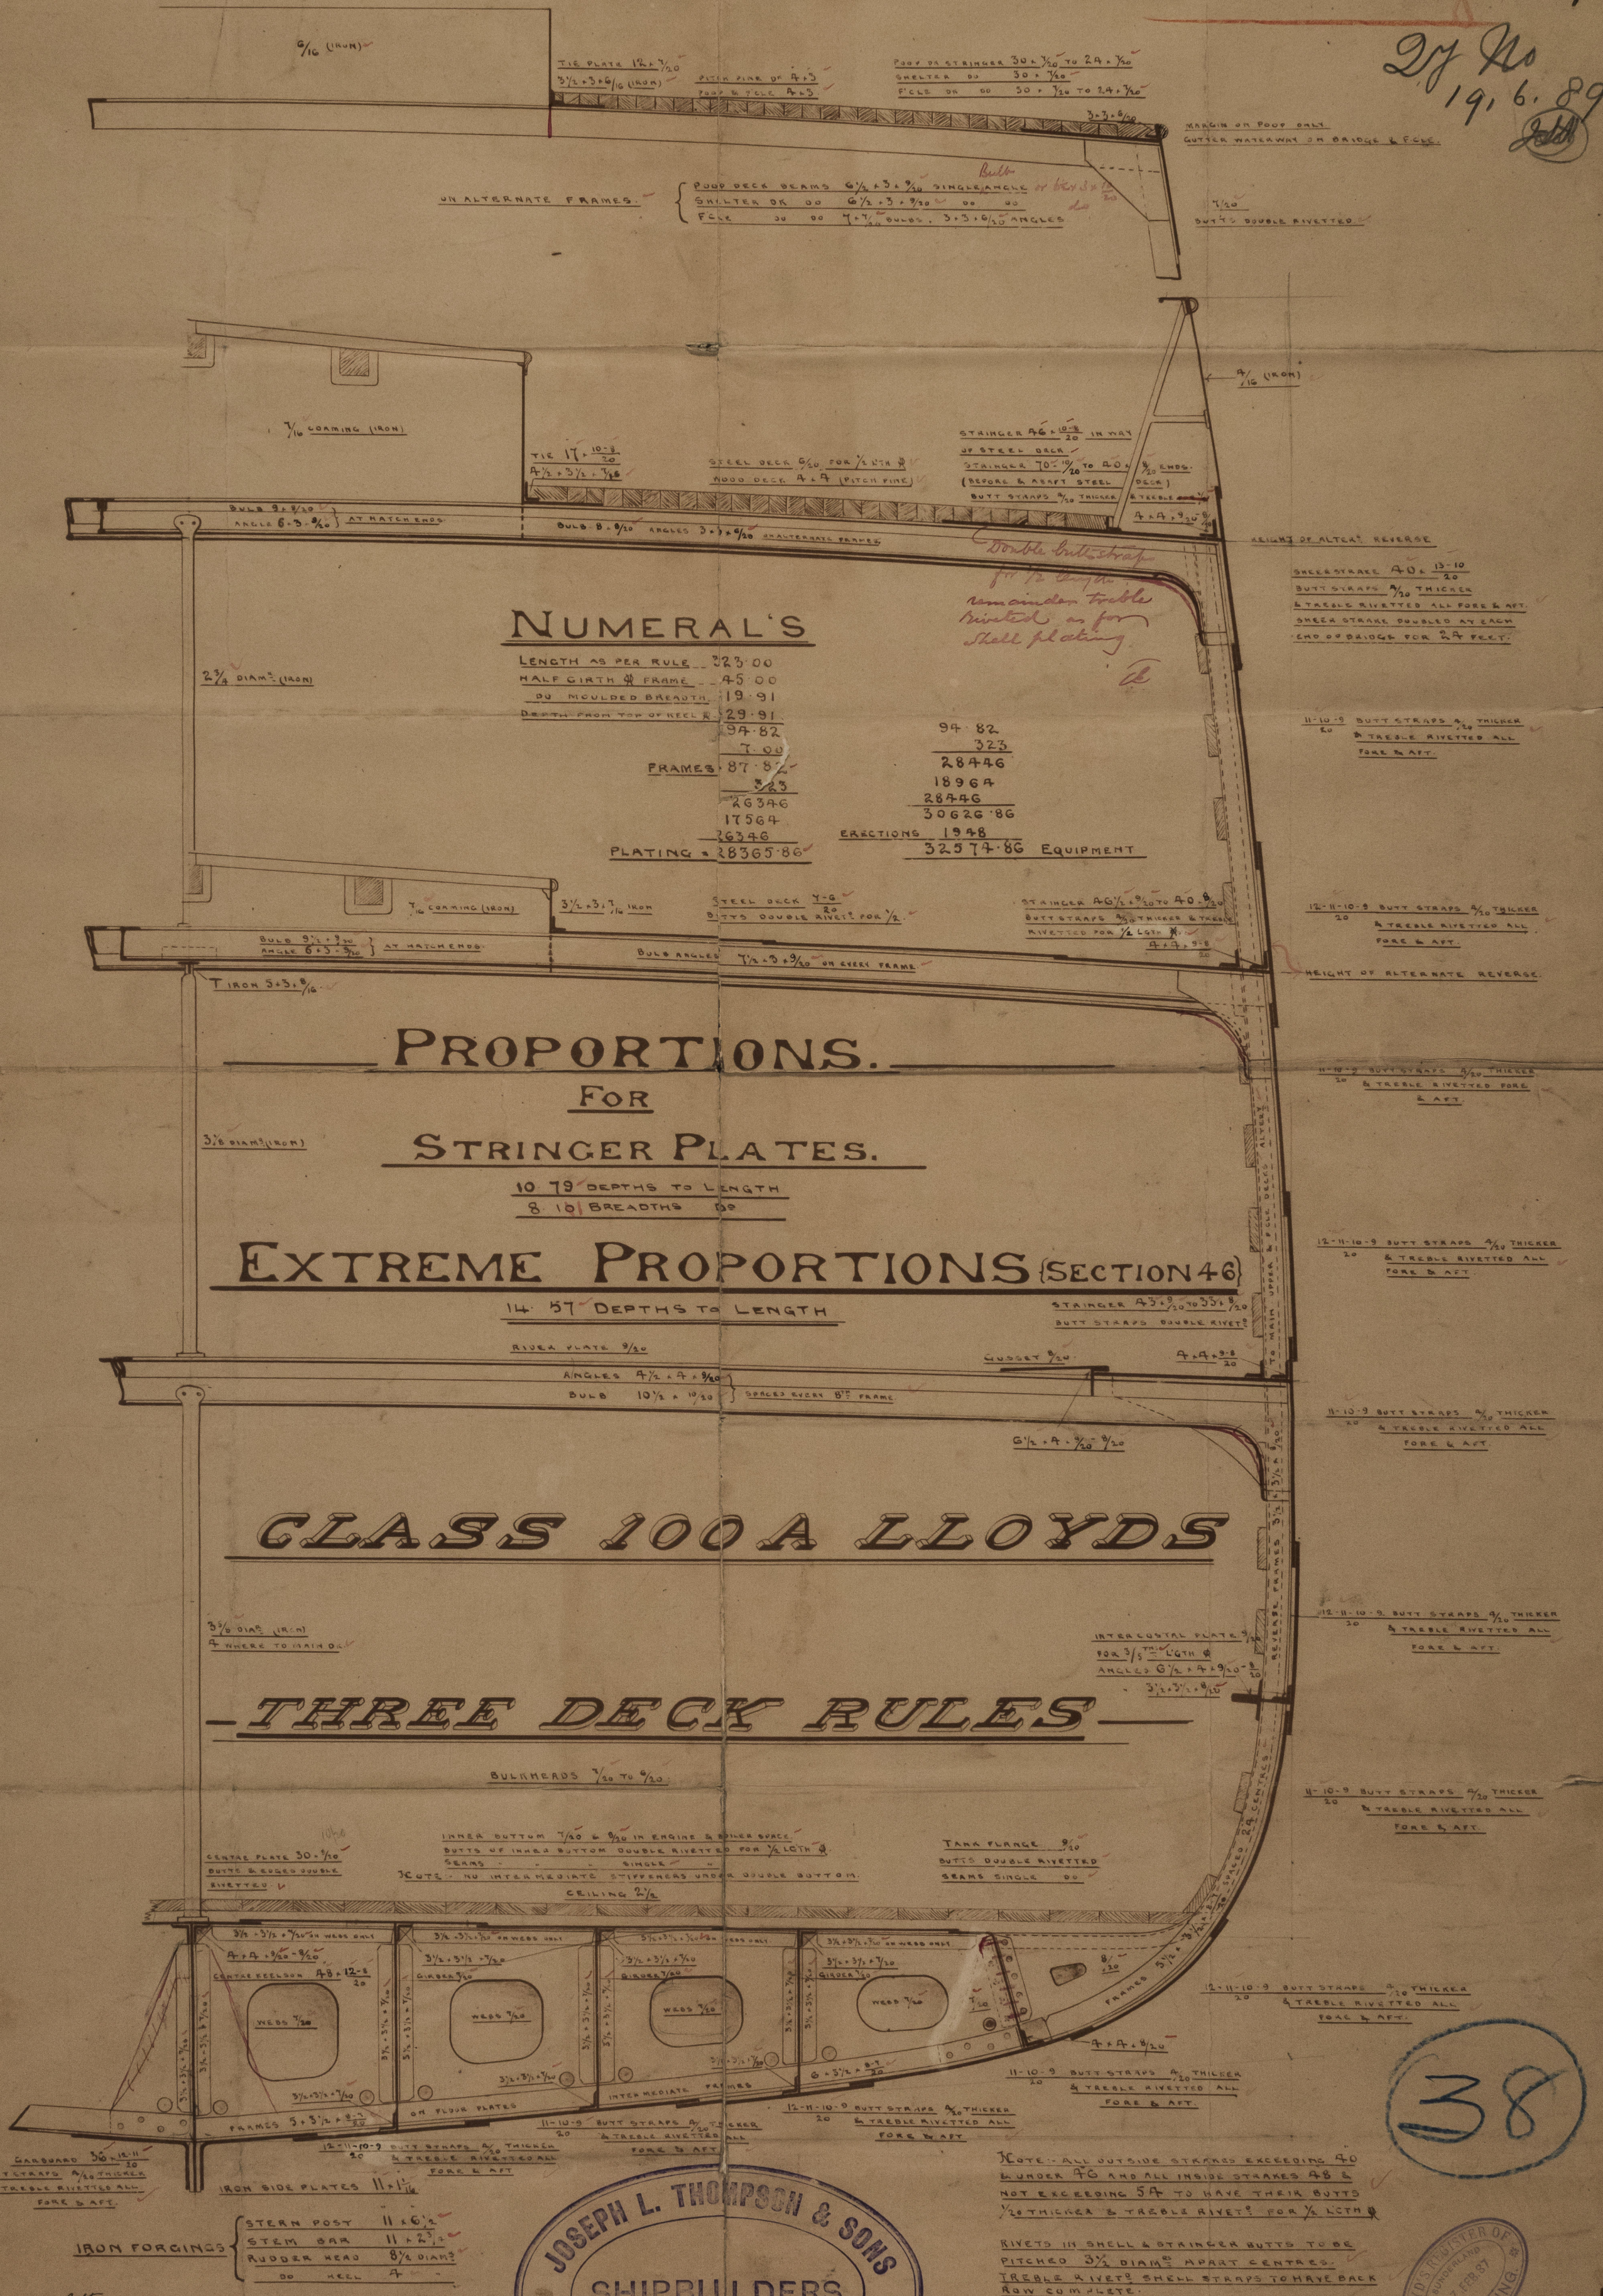

38

LLOYD'S REGISTER OF SHIPBUILDING

Lloyd's Register Foundation  
SLD455-0271



*Midship Section*

LLLOYD'S REGISTER OF SHIPPING  
RECEIVED  
19 MAY. 87  
LONDON

LLLOYD'S REGISTER OF SHIPPING  
RECEIVED  
20 JUN. 87  
LONDON

LLLOYD'S REGISTER OF SHIPPING  
RECEIVED  
26 OCT. 87  
LONDON

LLLOYD'S REGISTER OF SHIPPING  
RECEIVED  
2 NOV. 87  
LONDON

*[Faint handwritten text, possibly a list or ledger entry]*

*[Faint handwritten text, possibly a list or ledger entry]*

SLD955-0271



© 2021  
Lloyd's Register  
Foundation