


10.2.87.



# STEEL SCREW STEAMER N° 228

SCALE 1/8" = 1' 0"

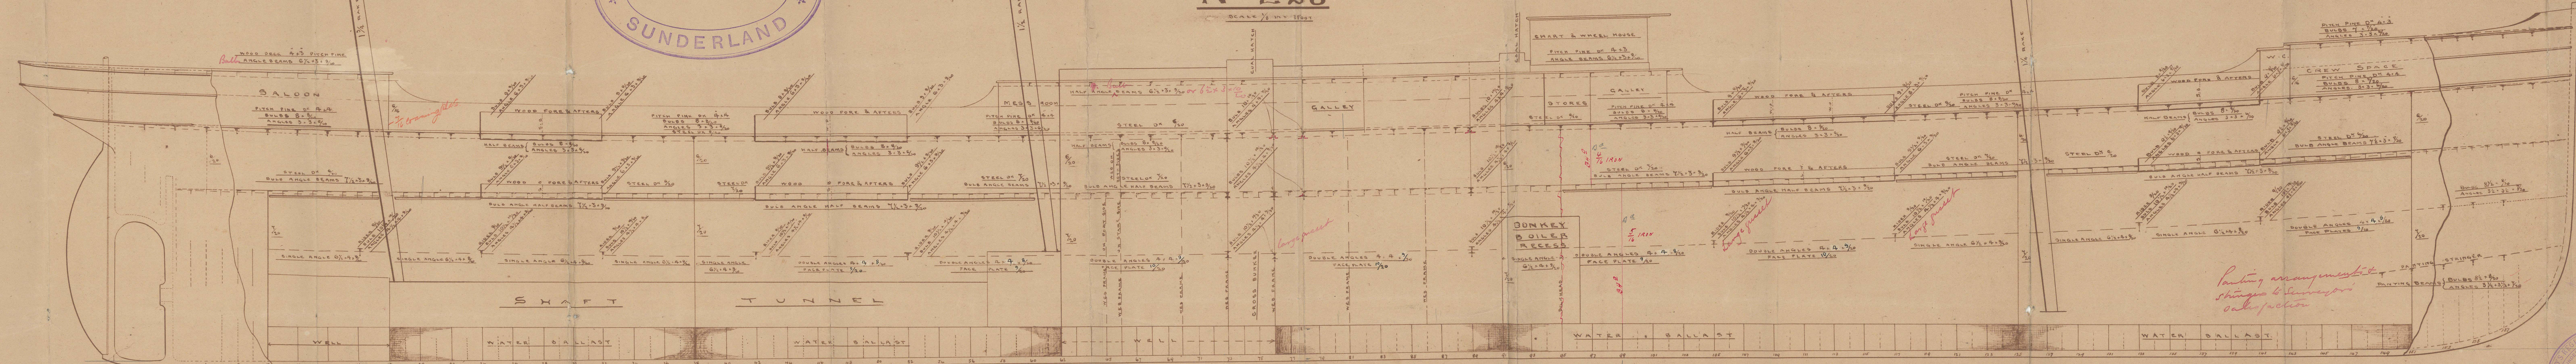

See letter  
10/2/87

20.9.87

29.5.87


Painting arrangement  
stringers to Surveyors  
satisfaction

32.6  
25.9  
8.9





Profile

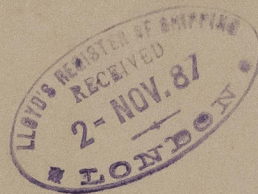

X




© 2021

Lloyd's Register  
Foundation

SLD955-0273



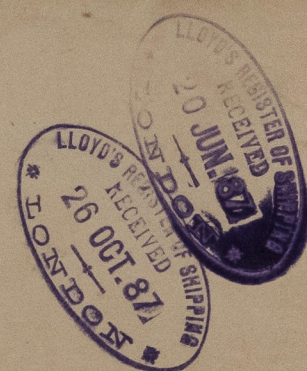

© 2021  
Lloyd's Register  
Foundation  
SLD955-0273