


Lt. 24/6/89

N<sup>o</sup> 228


SCALE 1/8" = 1 FOOT.

S. S. Murrenbridge Ltd. report No 14434.

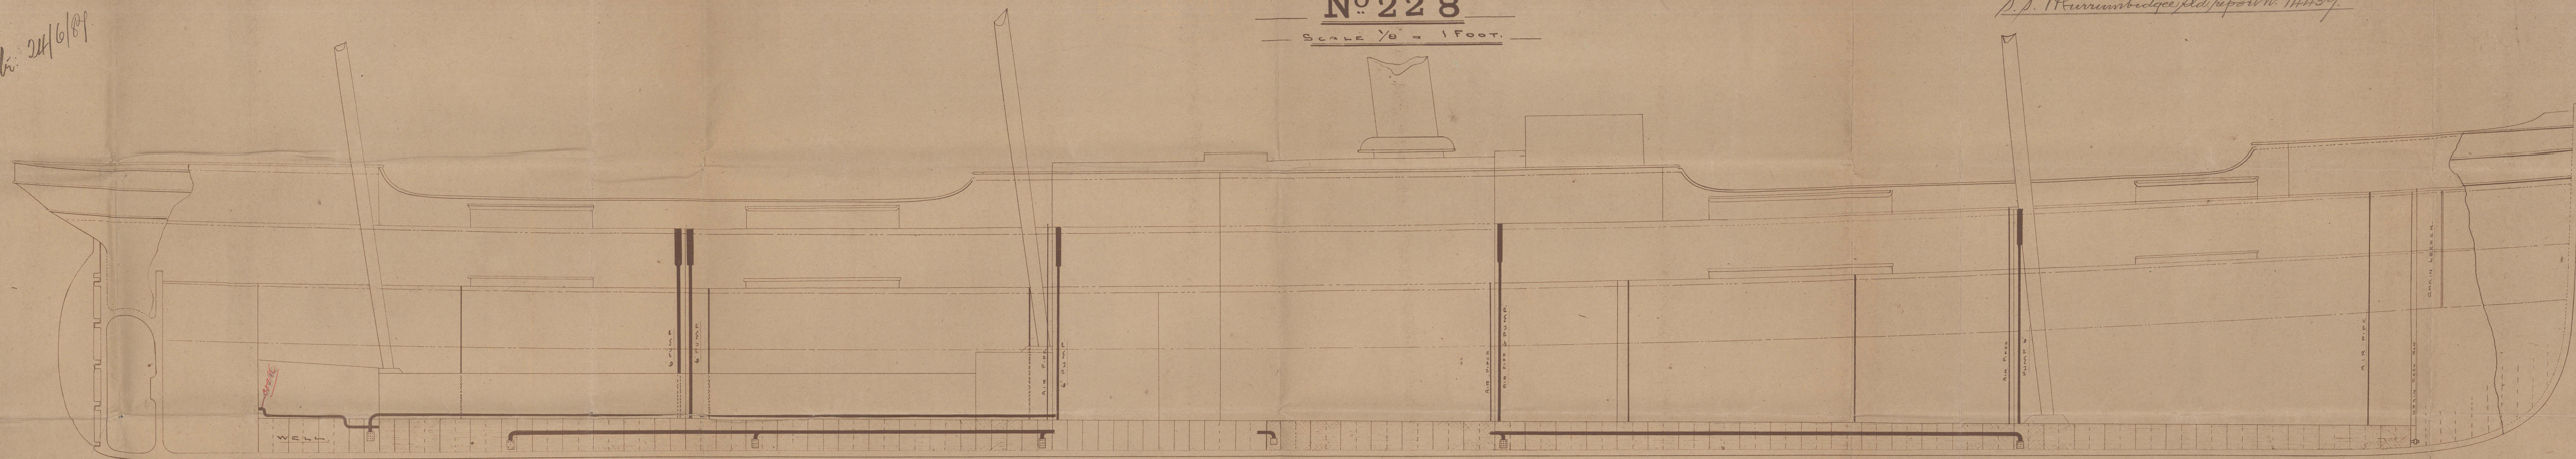

ALL BALLAST & HOLD SUCTION PIPES TO BE OF METAL.

JOSEPH L. THOMPSON & SONS  
SHIPBUILDERS  
SUNDERLAND

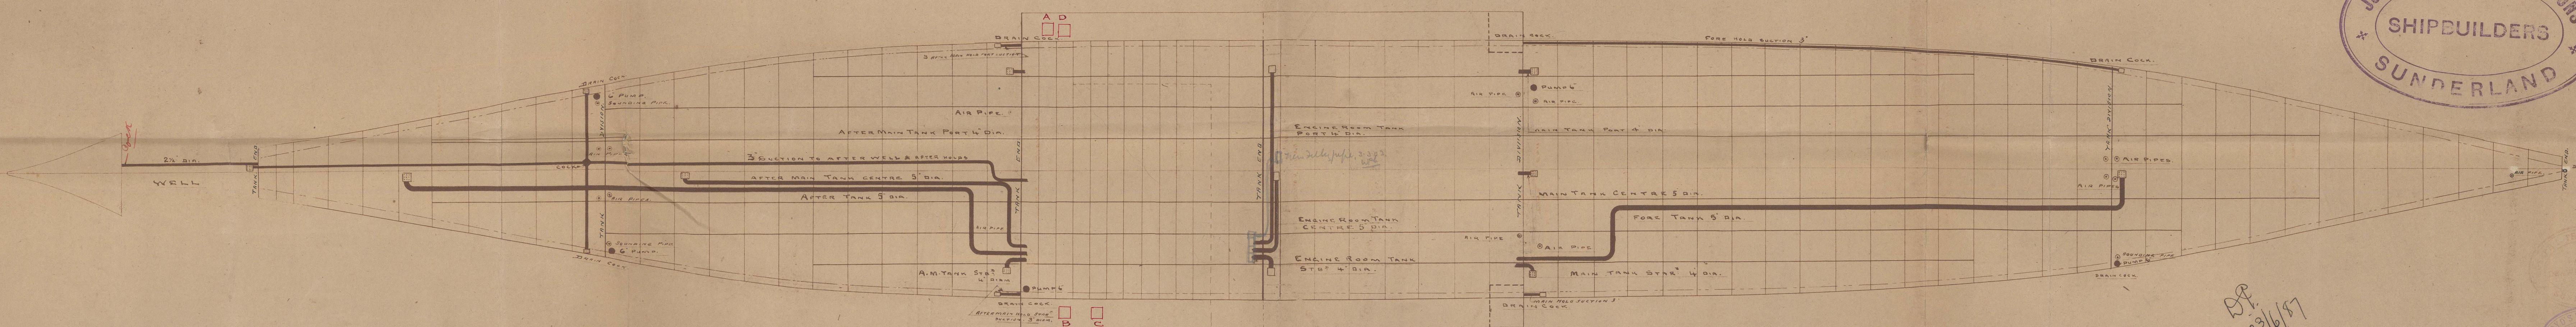

A & B MAIN ENGINE & BALLAST PUMP. BILGE INJECTION.  
C & D MAIN ENGINE & FEED PUMP.

29/6/87

REGISTERED  
SHIPBUILDERS  
SUNDERLAND


LR

© 2021  
Lloyd's Register  
Foundation



Lloyds  
No. 840  
Engine Luctions

4120 - 556075

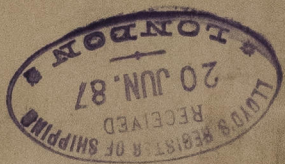

© 2021

Lloyd's Register  
Foundation