

# Lloyd's Register of British and Foreign Shipping.

(Report on Vessel No. 14434 Port Sunderland)

## No. 539 A SHIP FORGINGS OR CASTINGS.

I have to report that the undermentioned Iron or Steel Forgings or Castings, manufactured by Mr. J Richardson & Co of Northfleet for the Vessel No. 228, being built by Mr. J L Thompson & Sons of Sunderland have been inspected by me as set forth below, and found to be, so far as can be seen, sound and efficient.


Mark on Forgings.

**Lloyd's**  
No. 539 A  
H. C.

Hugh Cameron  
Sunderland

	STERN FRAME.	RUDDER FRAME.	STEM.
Material*	<u>Scrap iron</u>	<u>Scrap iron</u>	<u>Scrap iron</u>
How made	<u>Forged</u>	<u>Forged</u>	<u>Forged</u>
Dimensions	<u>11" x 6 1/2"</u>	<u>8 1/2" - 4"</u>	<u>11" x 2 3/4"</u>
Progress on Inspection	<u>Forged &amp; Smithed</u>	<u>Forged &amp; Smithed</u>	<u>Forged</u>
Dates when Inspected	<u>Dec 8-14-23/86</u>	<u>Jan 13-21-25-28 Feb 7-17-24</u> <u>March 3-9-15-28 April 2/87</u>	<u>Dec 14/86</u>

SKETCHES OF FRAMES SHEWING POSITION AND DESCRIPTION OF WELDS OF FORGINGS, OR PARTICULARS OF TESTS APPLIED TO CASTINGS.

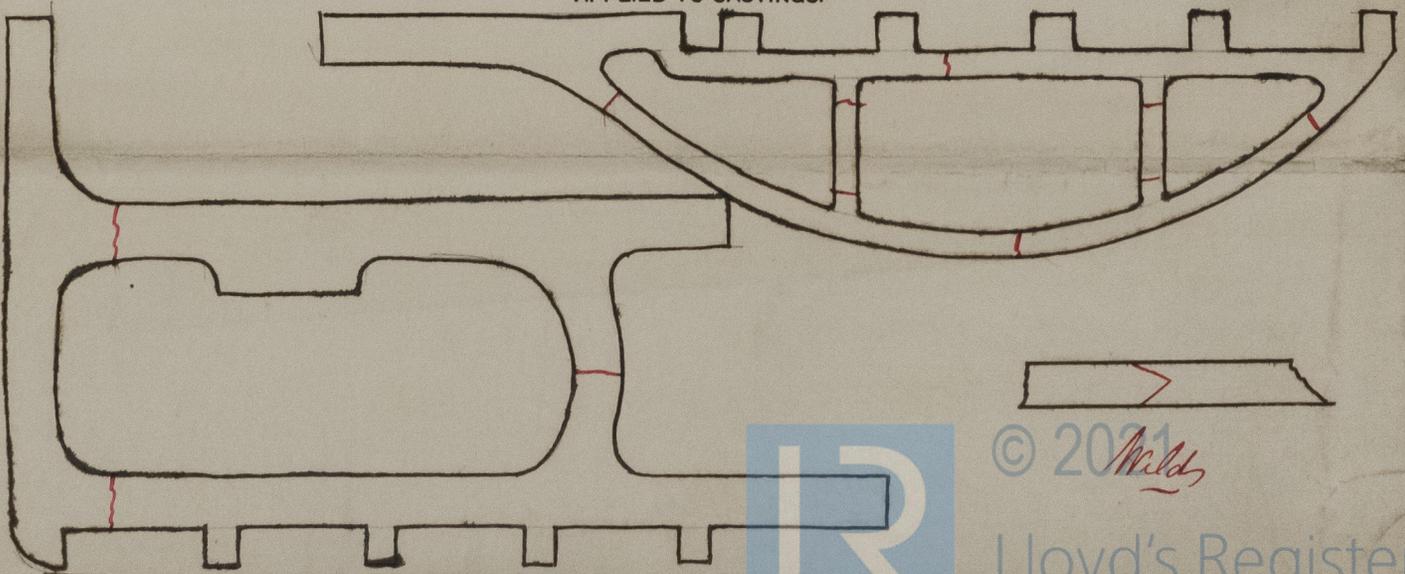

\* If of Iron, state whether scrap or puddled iron.