

RAMES. Anglo-Jamaican

on Forgings.

oyd's


152
166

McCammon

Sunderland

	STERN FRAME.	RUDDER FRAME.	STEM.
al*	Scrap Iron	Scrap Iron	Scrap Iron
made	Forged	Forged	Forged
nsions	10' x 6"	4 3/4' - 3 3/4'	10' x 2 3/4'
ss on Inspection	Forged Smithed	Forged Smithed	Forged
s when Inspected	July 2-8-11-14-17-22-29 Aug 1-15-26 Sept 4/84	Sept 4-10-17-26-30 Oct 11 17-21-24/84	Sept 4/84

SKETCHES OF FRAMES SHEWING POSITION AND DESCRIPTION OF WELDS OF FORGINGS, OR PARTICULARS OF TESTS APPLIED TO CASTINGS.

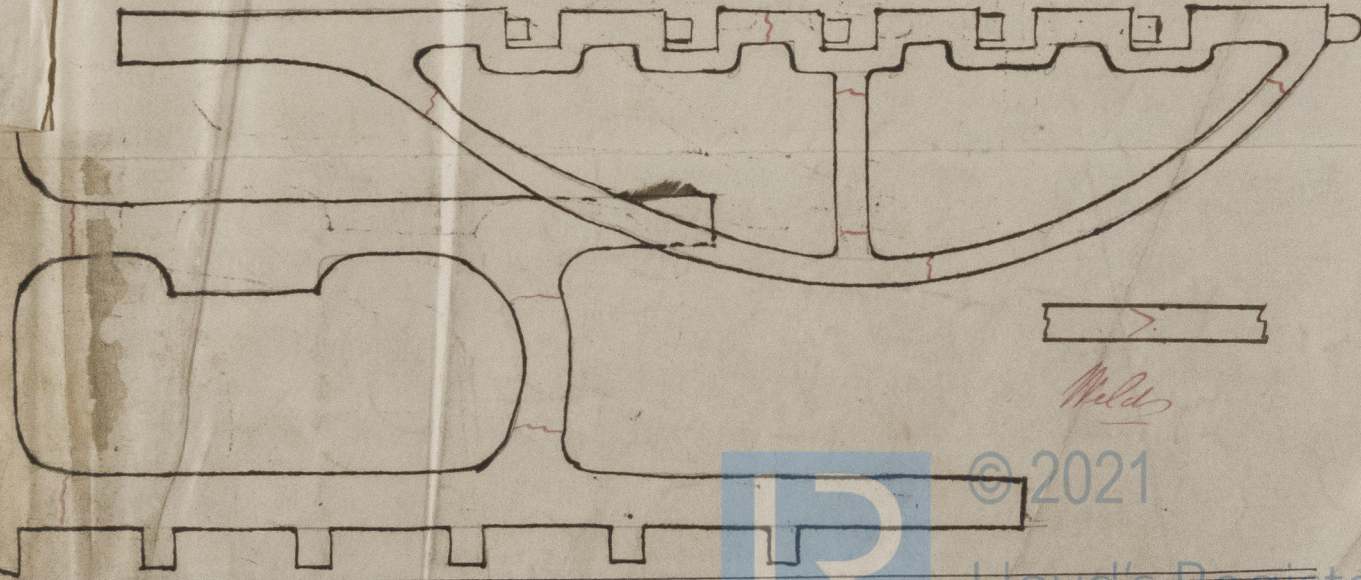

[T-1000-Mar./84-Trans. Ink.]

* If of Iron, state whether scrap or puddled Iron.

© 2021
Lloyd's Register
Foundation

Butts of Main Sheerstrake, treble riveted for 3/4 length amidships. Butts of Upper or Spar Sheerstrake, treble riveted for 3/4 length amidships. Butts of Upper or Spar Stringer Plate, treble riveted for 3/4 length amidships.