
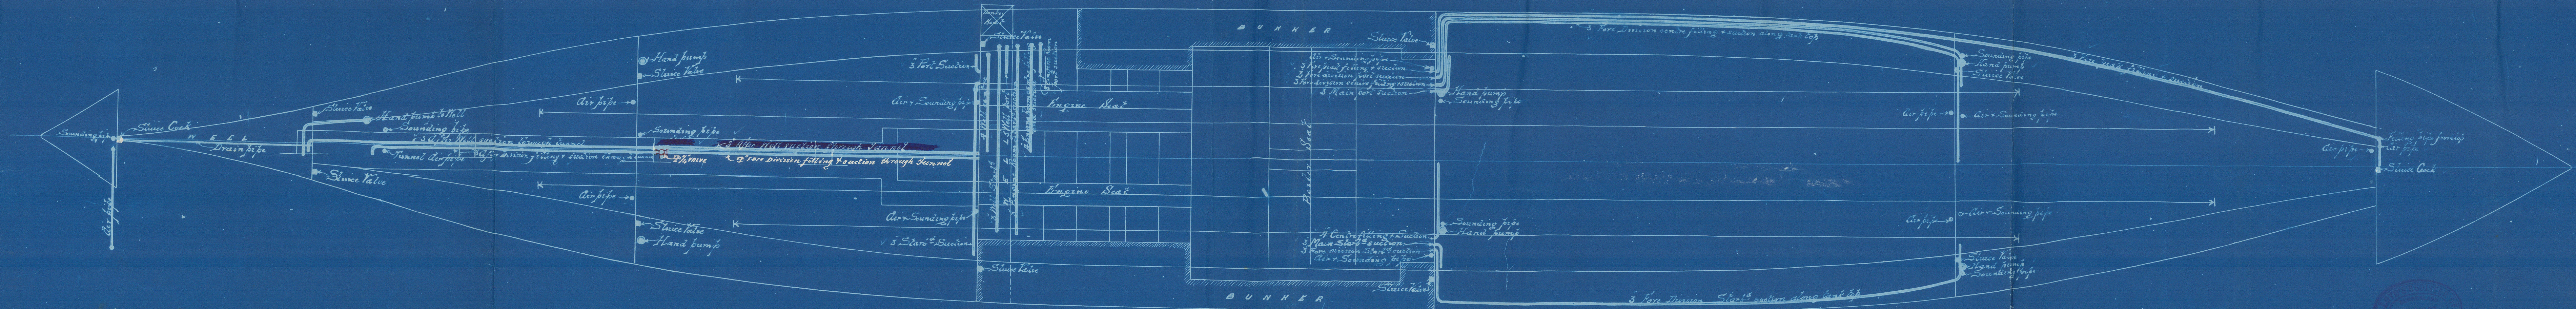


dkr to ddr 28/3/07

—PUMPING ARRANGEMENT—  
—S.S. N° 144—  
—SCALE 1/8" = ONE FOOT—

S. J. Mike Maru/Slareport W 14562

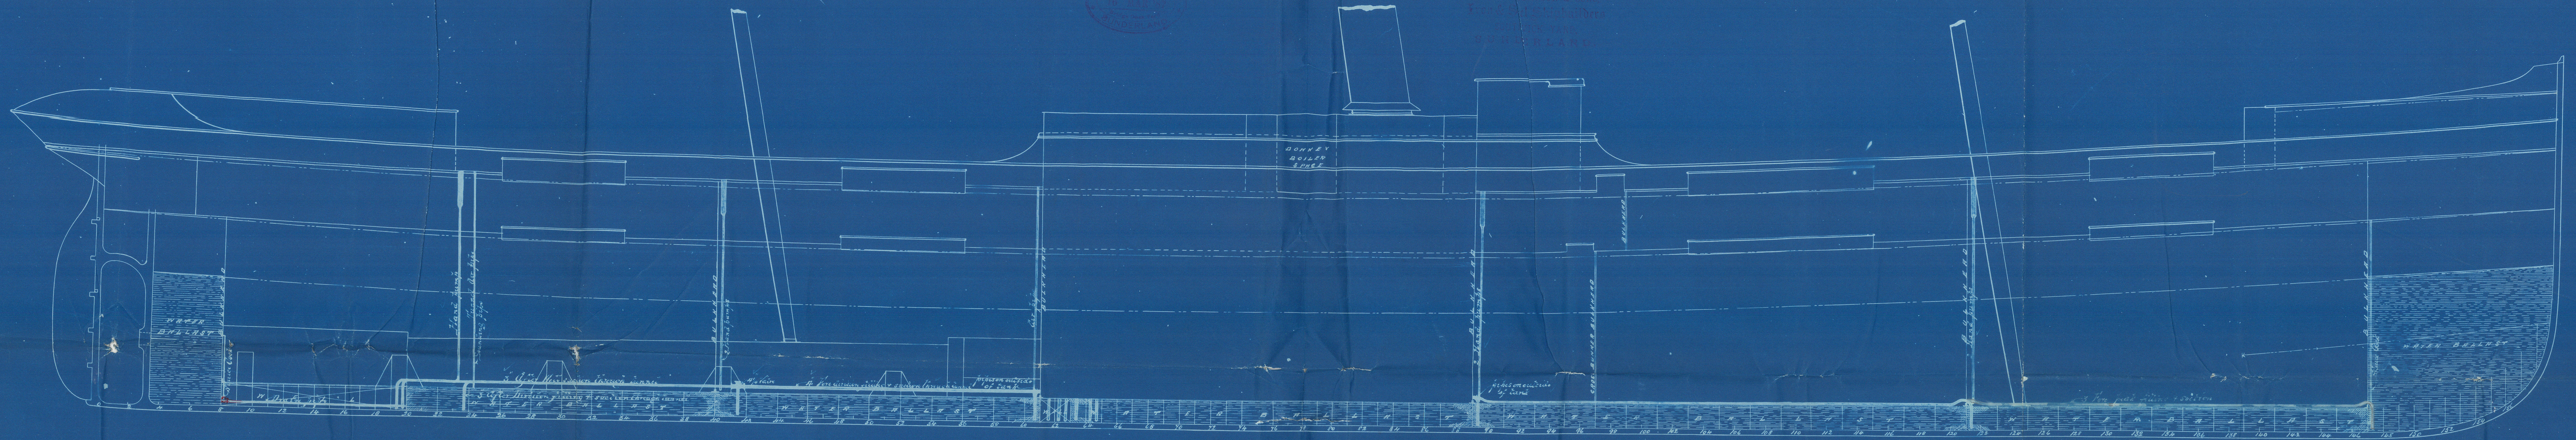

—NOTE—  
PUMPS IN HULL TO BE  
FITTED BY ENGINEERS

ROBERT THOMPSON & SONS,  
STEAM AND SHIP ENGINEERS AND  
MECHANICAL ENGINEERS,  
SOUTHVIEW YARD, HILL DOCK, 1,  
SUNDERLAND.

ROBERT THOMPSON & SONS,  
STEAM AND SHIP ENGINEERS AND  
MECHANICAL ENGINEERS,  
SOUTHVIEW YARD, HILL DOCK, 1,  
SUNDERLAND.



SLD956-0725



© 2021

Lloyd's Register  
Foundation