



20.1.87  
 42.87  
 11.2.87

— N° 144 —  
 — BEAM ARRANGEMENT —  
 Scale  $\frac{1}{16}$  Inch = 1 Foot

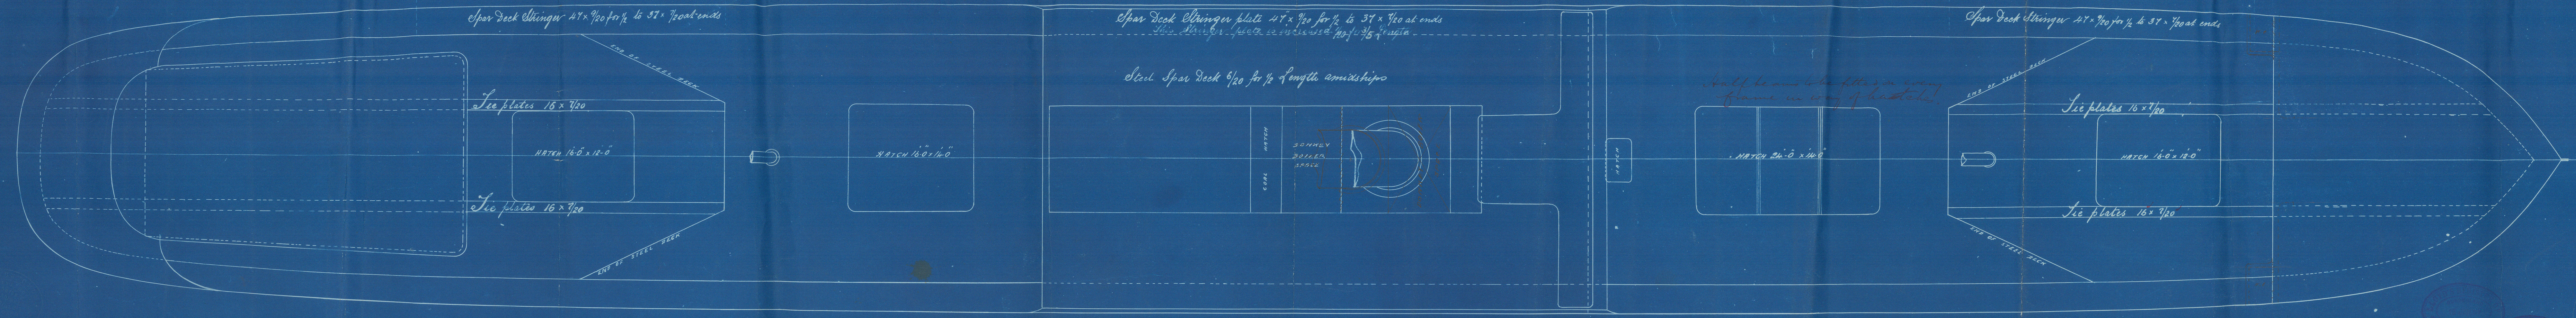

20/1/87

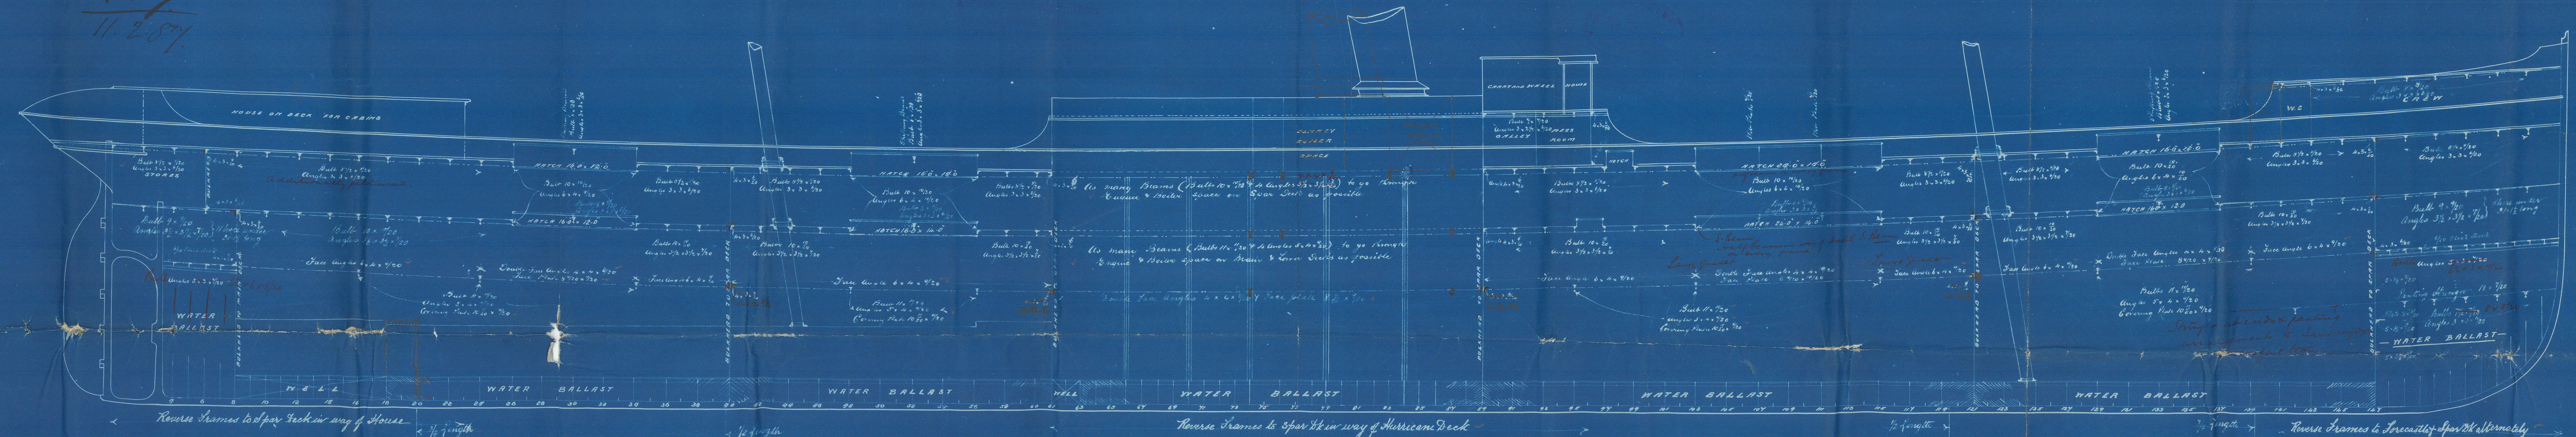

SLD956-0226



© 2021

Lloyd's Register  
Foundation



