
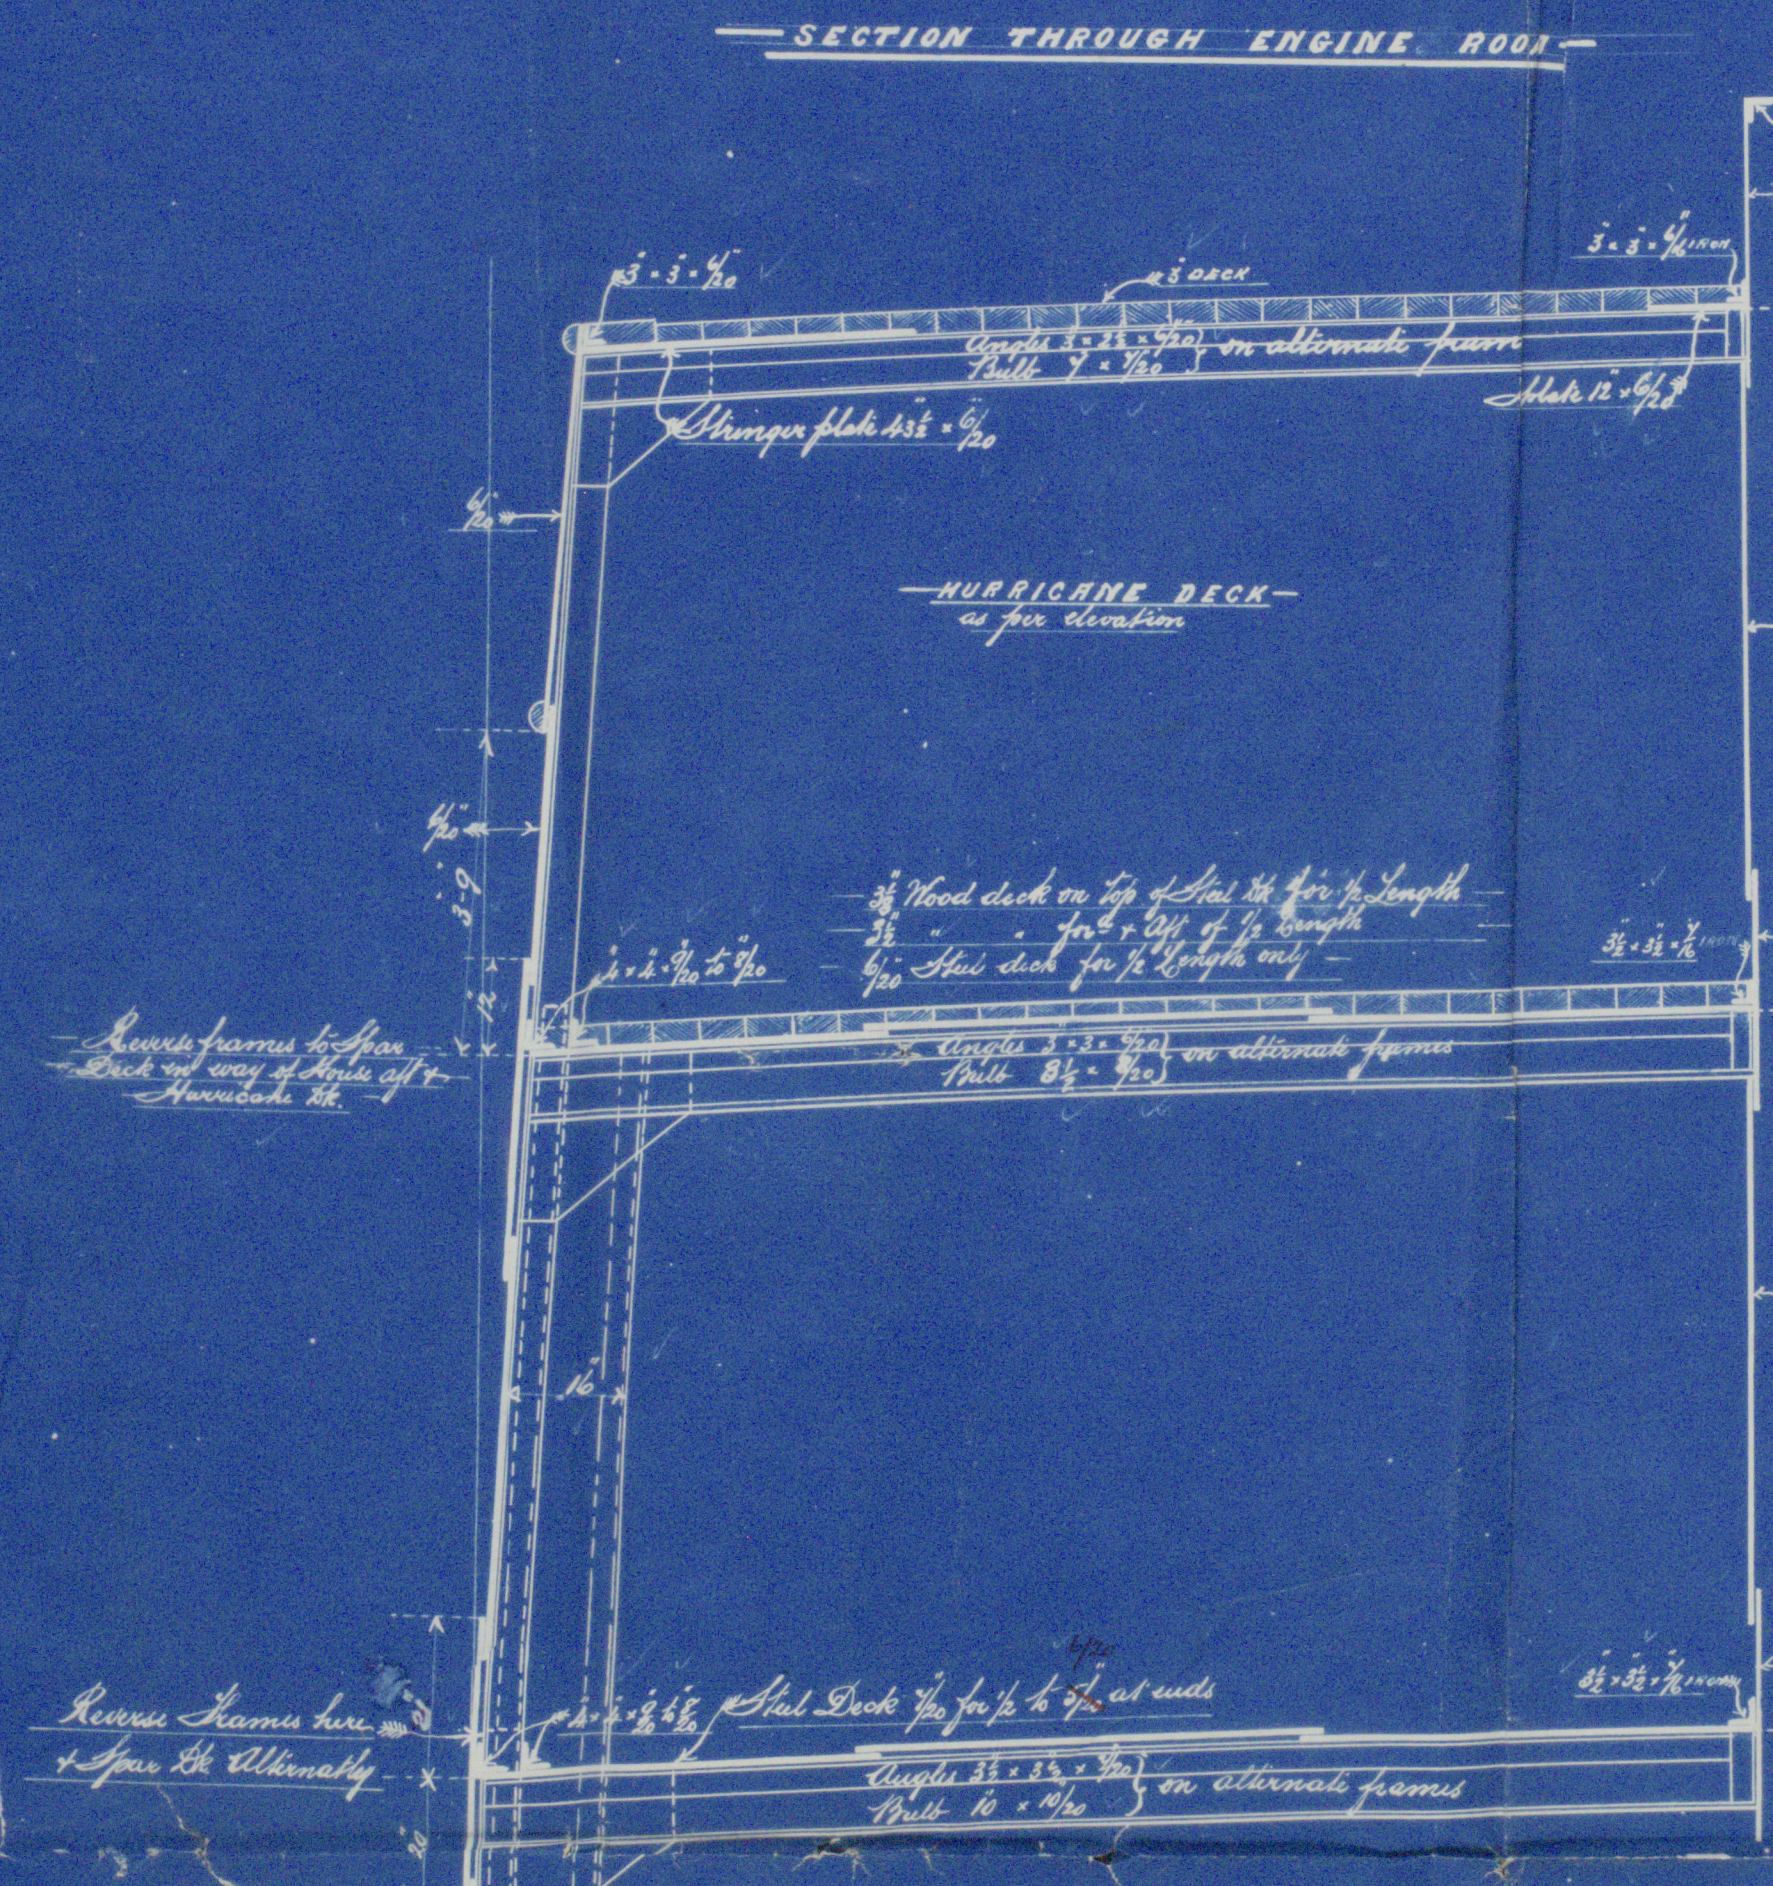
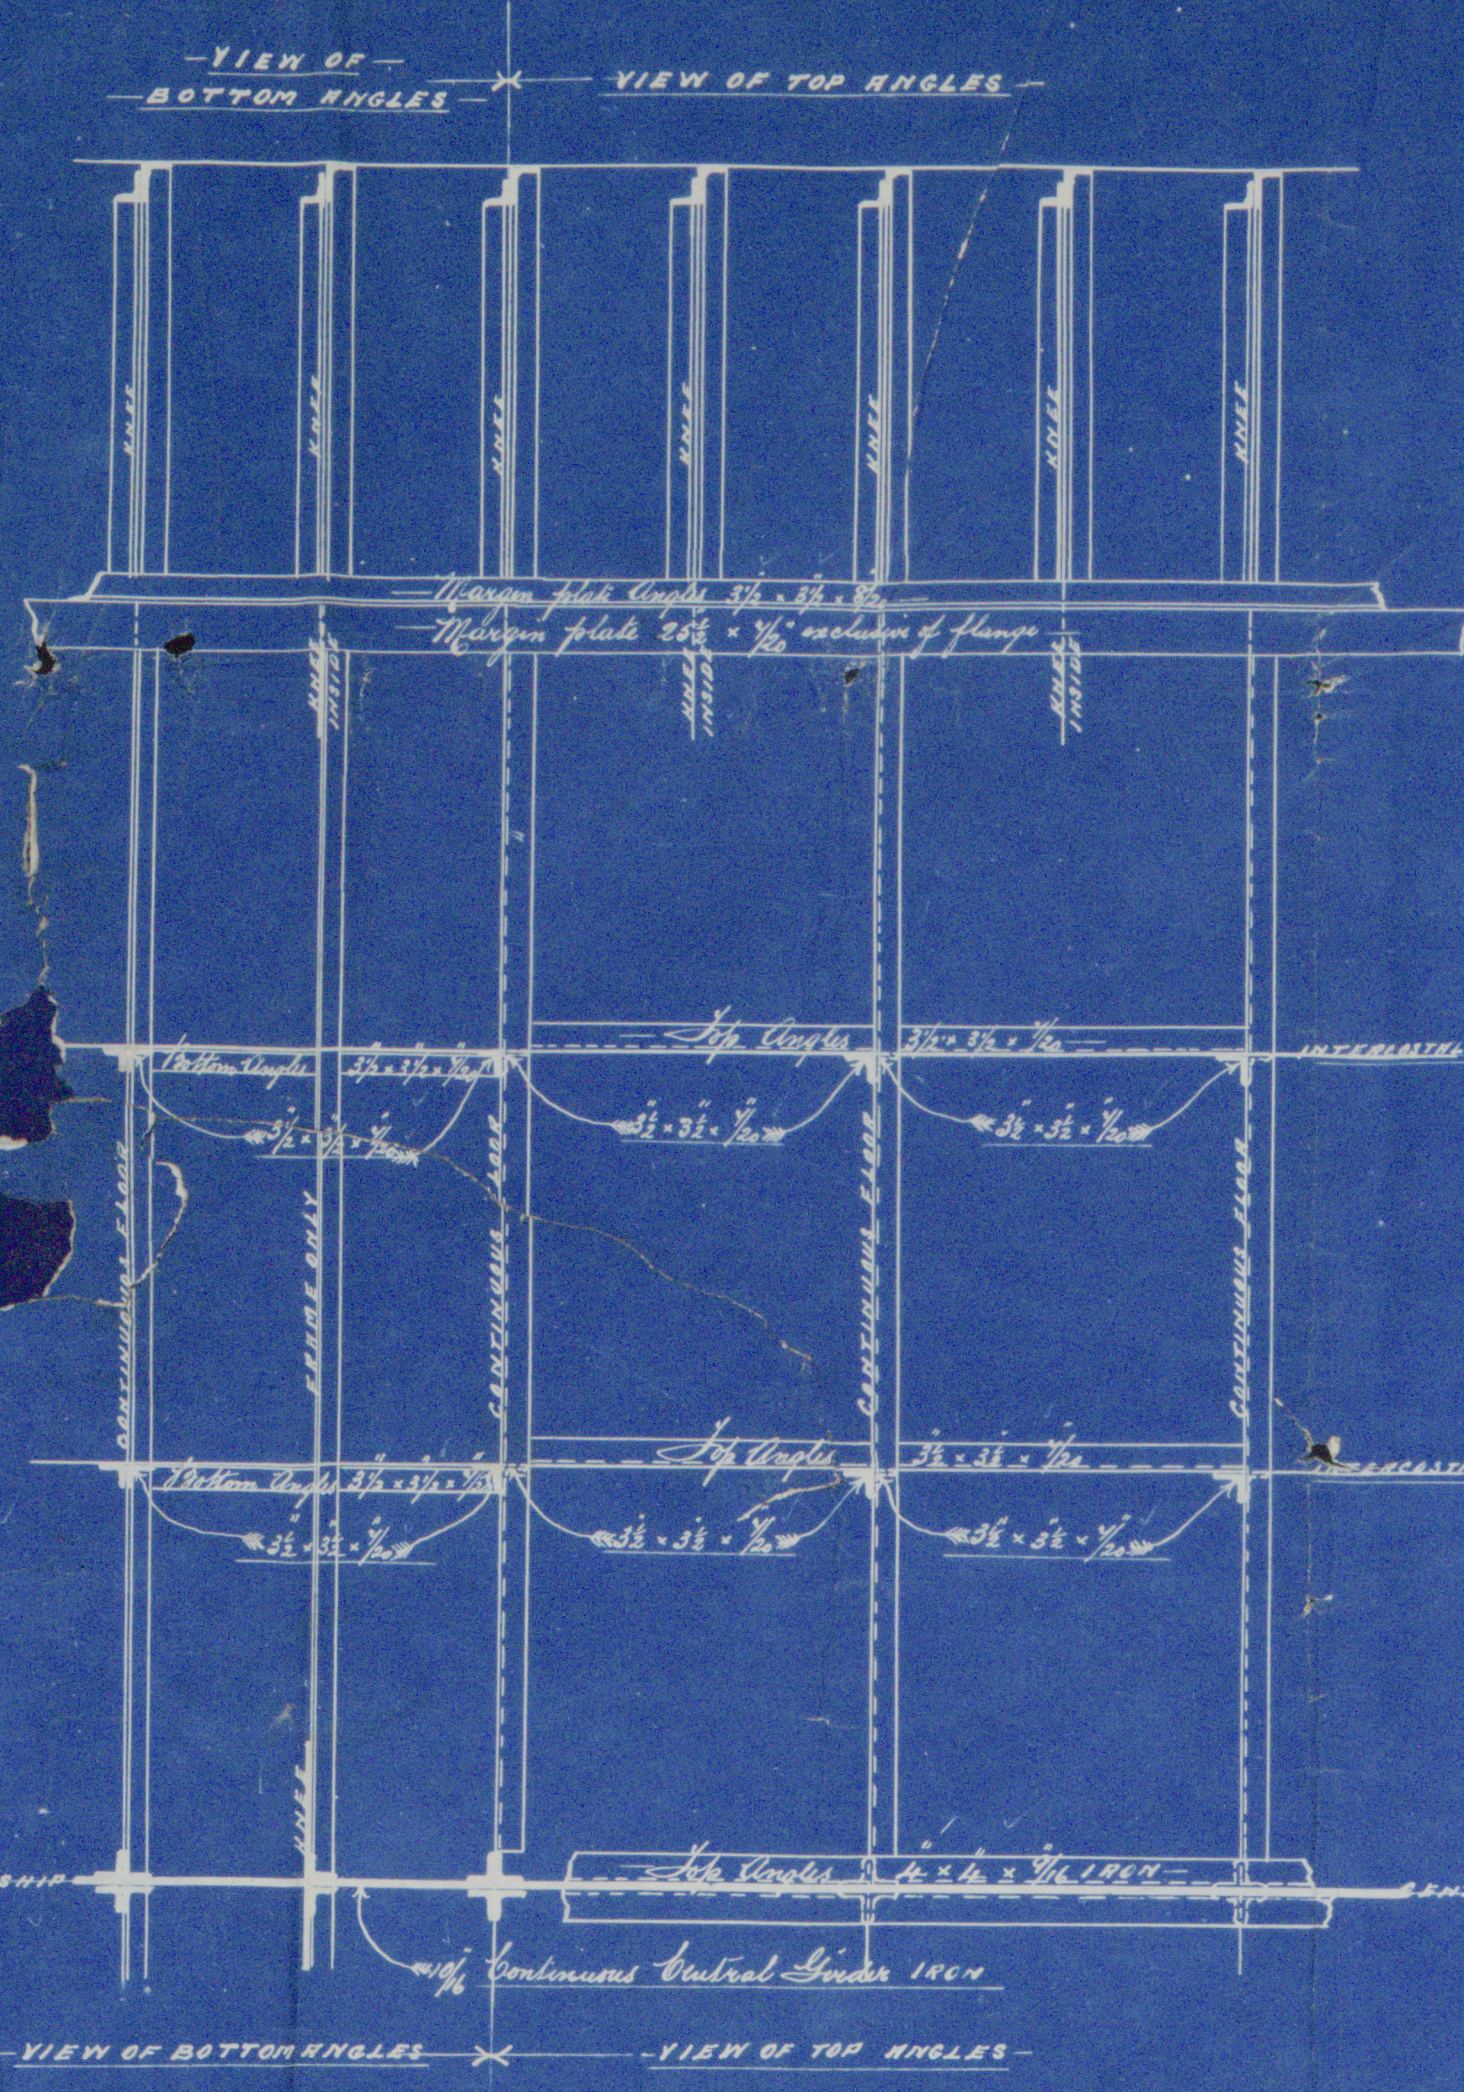


Copy
N^o 144
STEEL SCREW STEAMER
 Length between girders 320.0
 Beam extreme 22.0
 Depth 15.0
 Depth of hold below deck to spar 28.9
 Depth of hold below deck to spar 21.0
 Cellular bottom to spar 21.0
 CLASS 100 RI. Spar & Hatch Area
 Scale 1/2" = 1 foot


Anchor & Chains etc.
 EQUIPMENT NO. = 32579
 1 Iron Anchor 36.2.0 ea of steel
 1 Chain 36.2.0
 1 Collar 10.4.0
 1 Iron Chain 11.1.0 ea of steel
 1 Ring 5.2.0
 1 Ring 2.3.0
 300 fms. of 1 1/2" steel chain cable
 90 " 1 1/2" 1/2" chain
 100 " 1 1/2" 1/2" chain
 90 " 1 1/2" 1/2" chain
 90 " 1 1/2" 1/2" chain

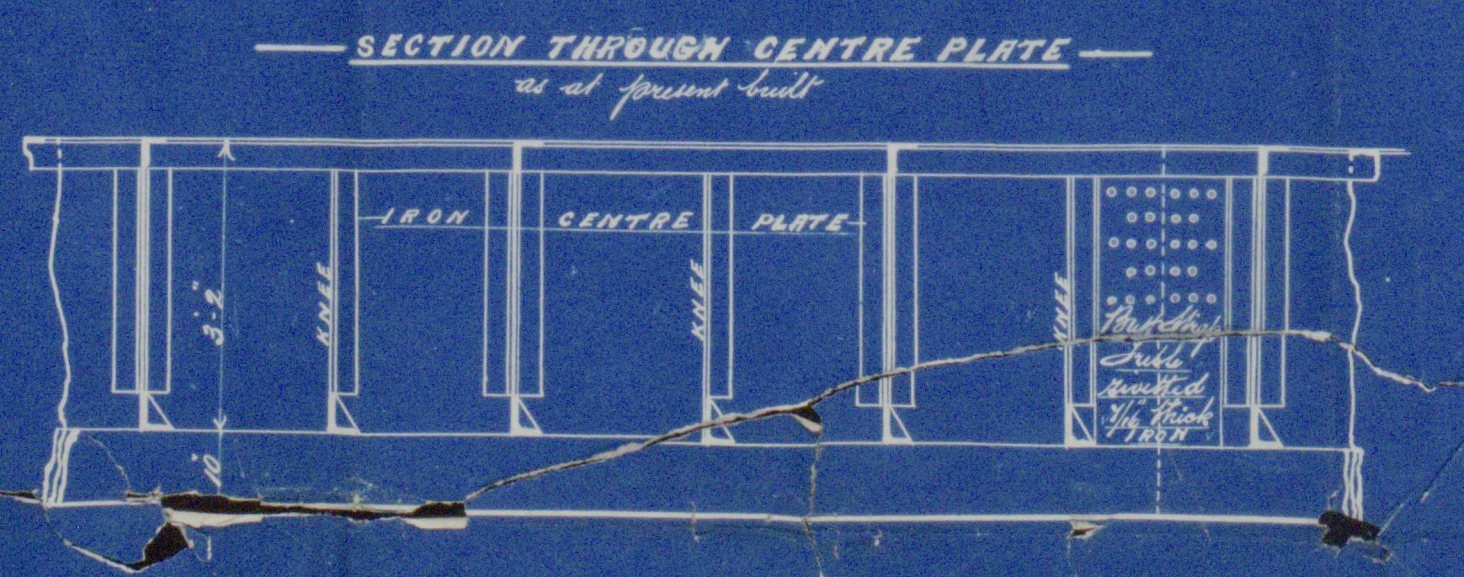

LOYDS NUMBERS


Beam	20.10

90.5 x 311.4 = 28,276 + 1/2 of 1/2" for anchors = 32579 Equipment No.

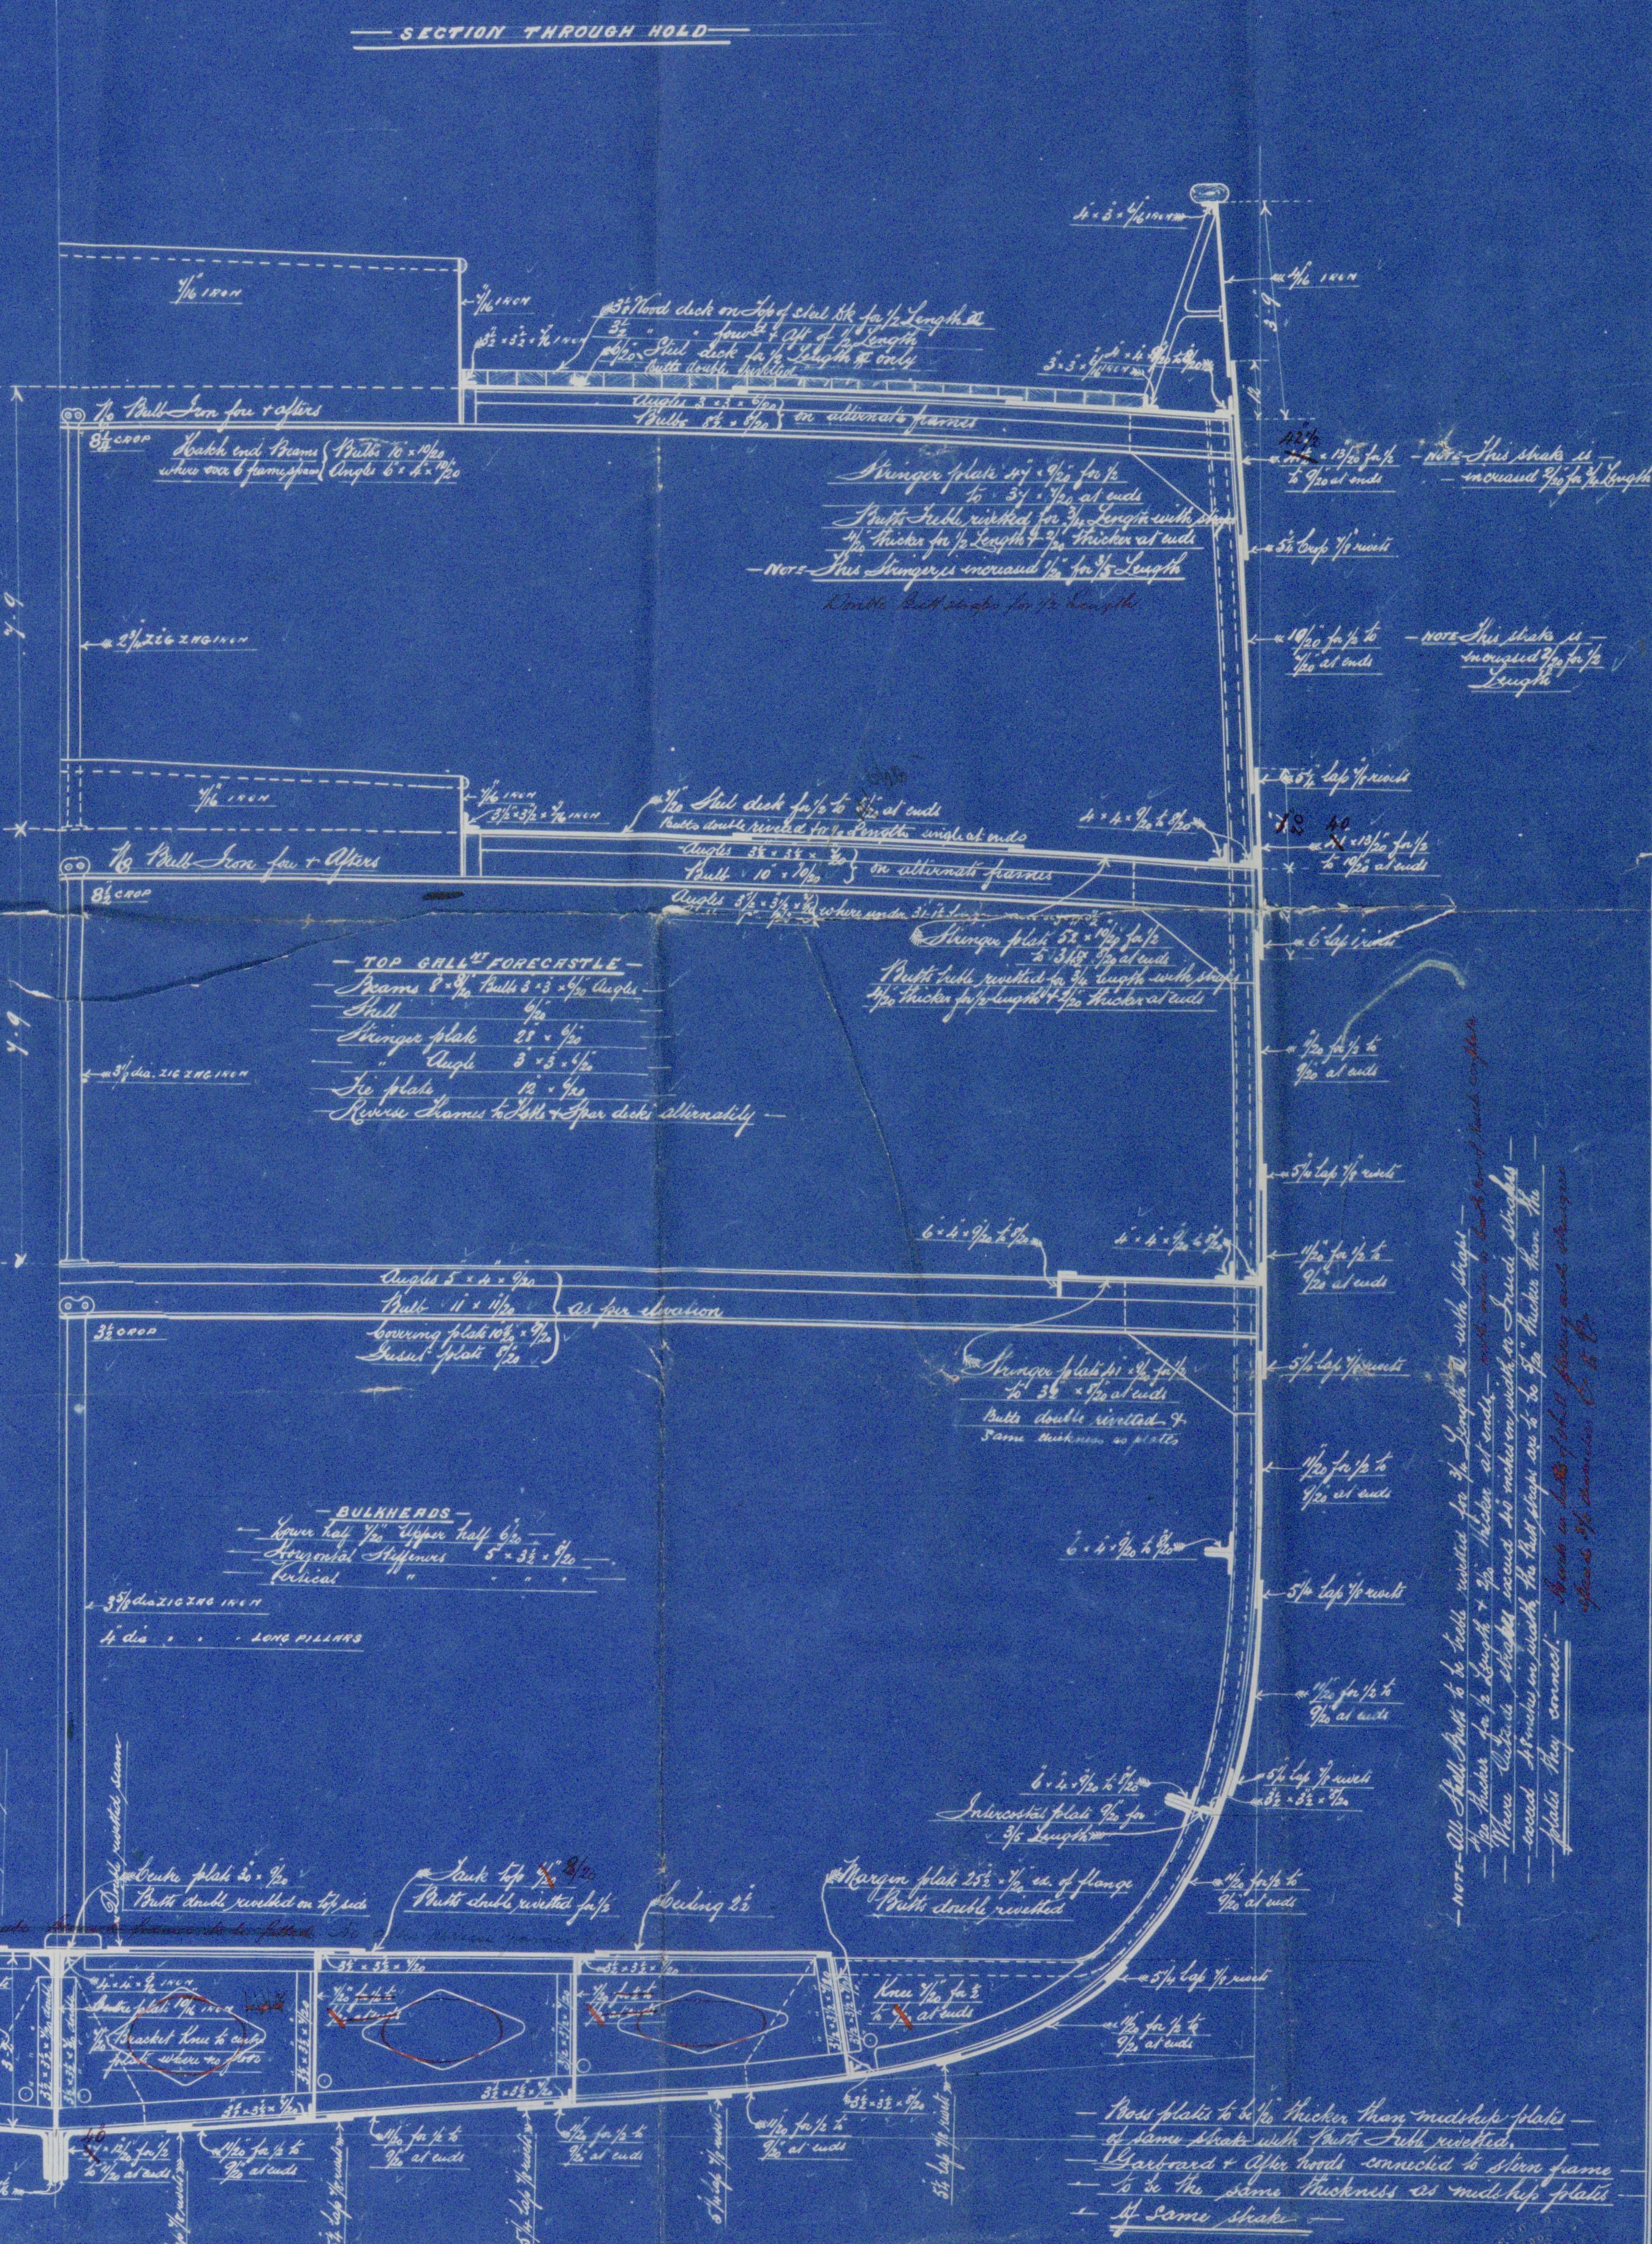

*Copy of approved section
 which has been forwarded*



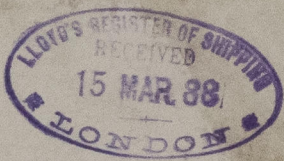

© 2021

Lloyd's Register
Foundation

SLD956-0231