

15.12.87




Nº 232 S.S.  
SCALE 1/8" = 1 FOOT

S.S. *Meta* Sld. report No.


BRIDGE DECK


IRON DECK 5/16 BUTTS SINGLE

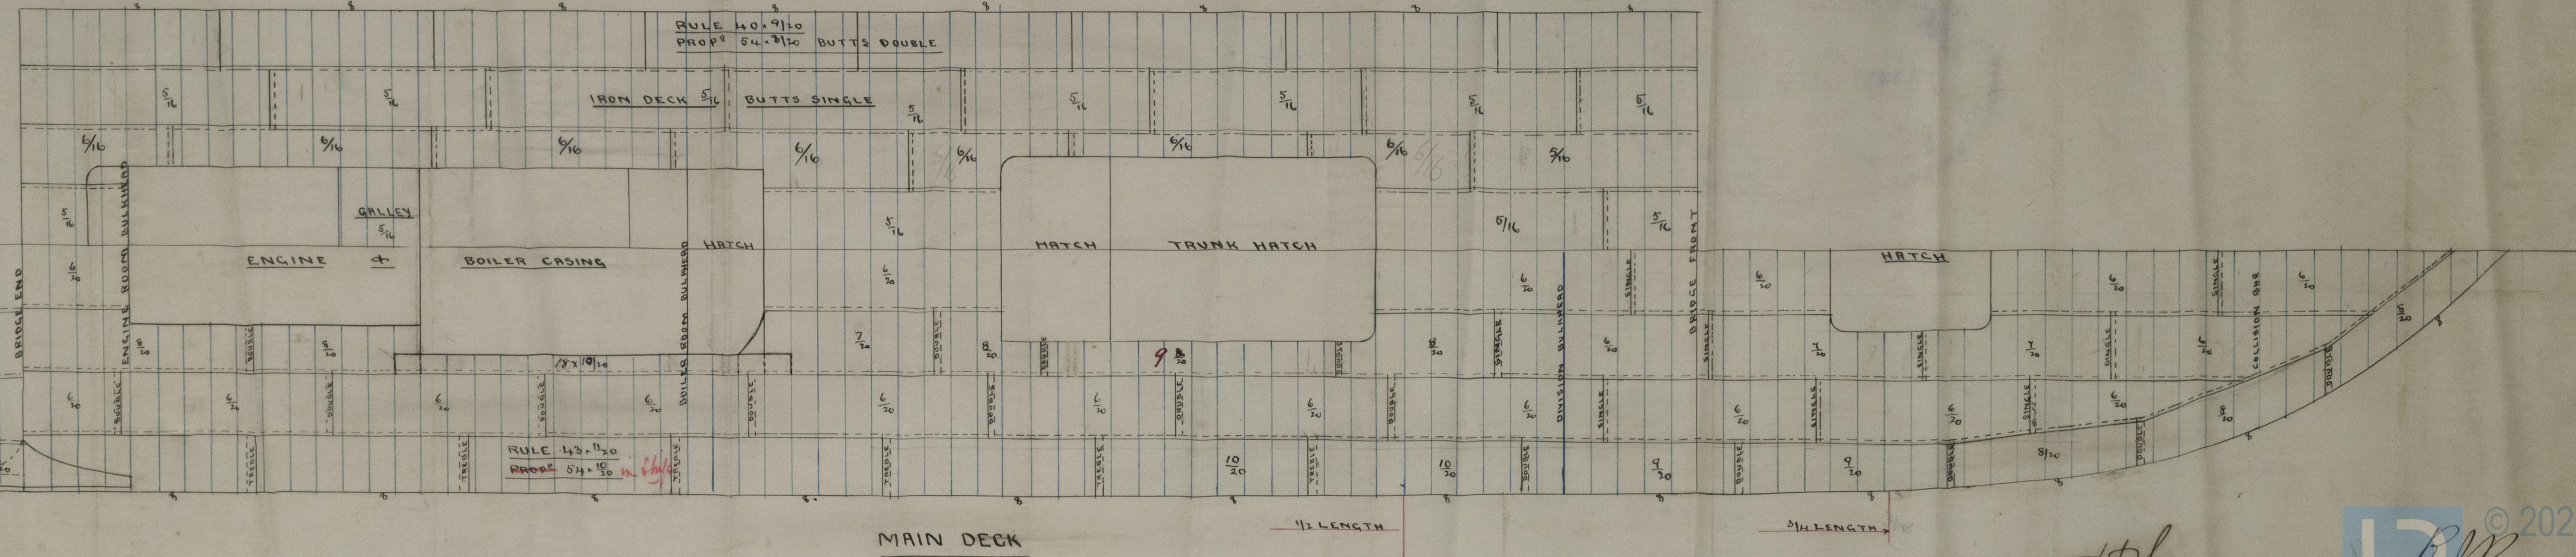

QUARTER DECK

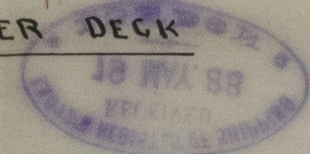


J.F.L.  
15/12/87



1110-6567-0171



SLD957-0171

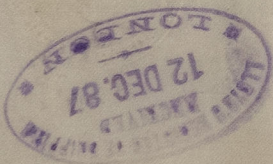

12.15.87

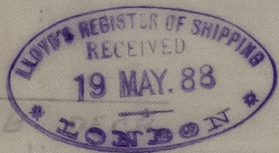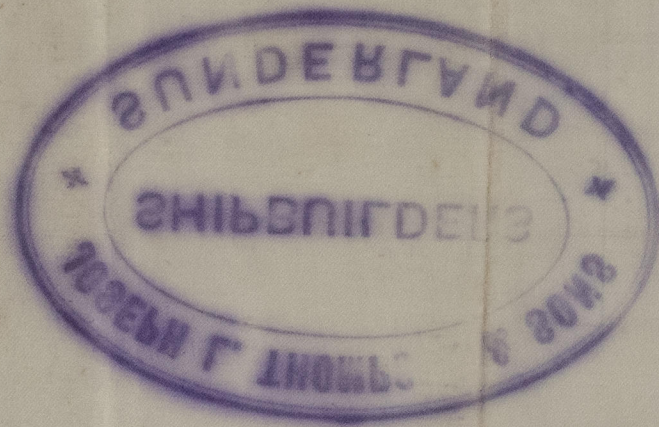

© 2021

Lloyd's Register  
Foundation