
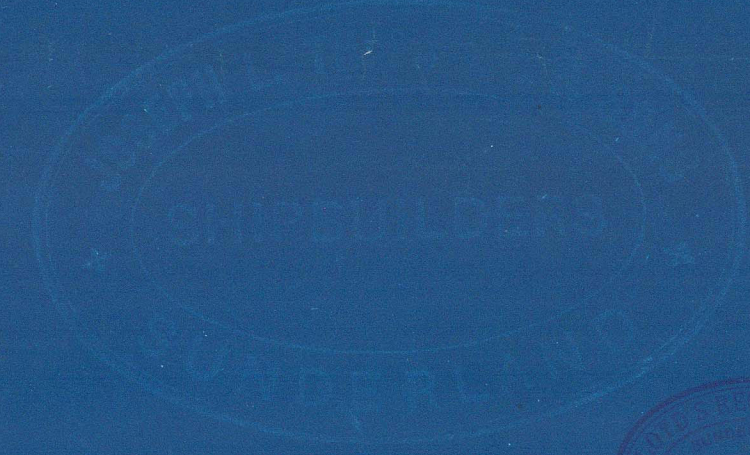


SCREW STEAMER

Nº 232

S.L. Metcalf's report No. 14626
10.1.88

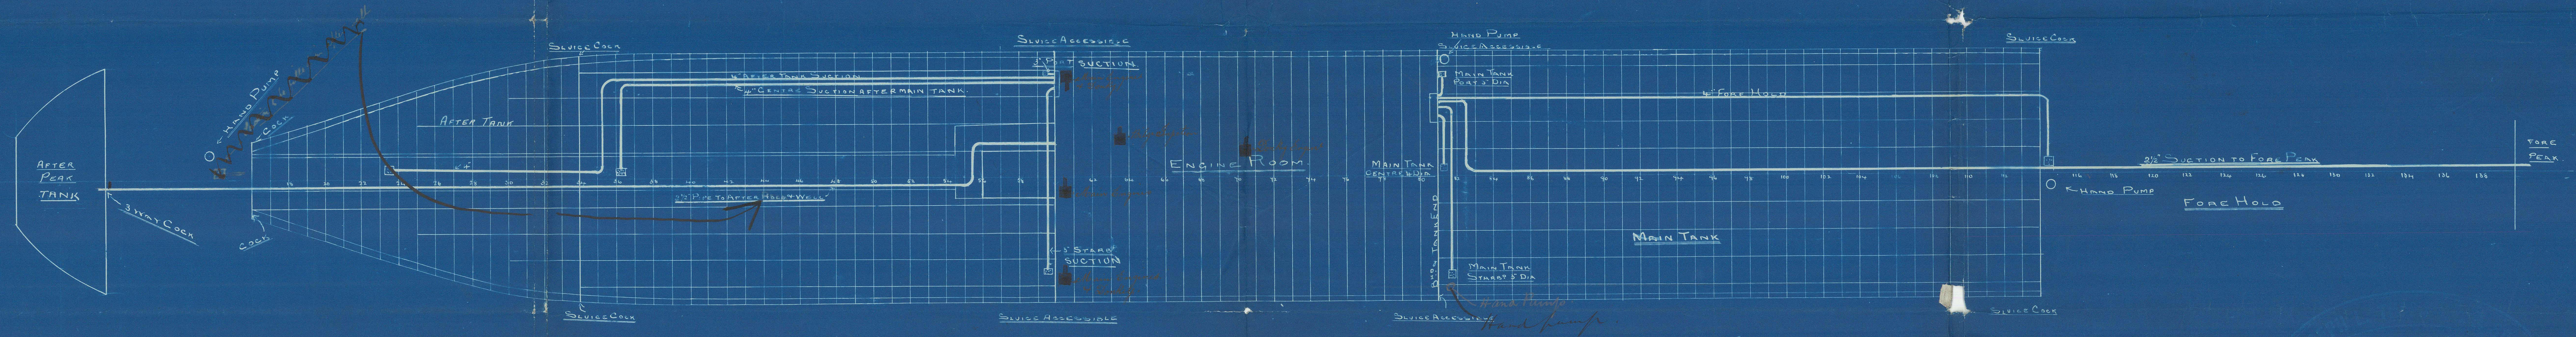

2610-656975



© 2021

Lloyd's Register
Foundation