

The words FORGINGS or CASTINGS, IRON or STEEL, should be struck out as may be required.

Sunderland

Lloyd's Register of British and Foreign Shipping.

(Report on Vessel No. 14626 Port Sunderland)

No. 704a SHIP FORGINGS OR CASTINGS.

I have to report that the undermentioned Iron ^{and} or Steel Forgings or Castings, manufactured by The Sunderland Forge Co. of Pallion for the Vessel No. 232, being built by Messrs J & R Thompson Sons of Sunderland have been inspected by me as set forth below, and found to be, so far as can be seen, sound.


Mark on Forgings.

Lloyd's
No. 704a
R.B.

Hugh Cannon
Sunderland 12/3/88

	STERN FRAME.	RUDDER FRAME.	STEM.
Material*	Scrap steel & iron	Scrap steel & iron	Scrap steel & iron
How made	Faged	Faged	Faged
Dimensions	10' x 6'	7 3/4 - 3 3/4	10' x 2 3/4
Progress on Inspection .	Faged Smithed	Faged Smithed	Faged
Dates when Inspected	Dec 21 Nov 2-9-15-21-26/88 Jun 6-10-16-18-21-26-28-30 Feb 2-8-15-18/88		Nov 2-9/88

SKETCHES OF FRAMES SHEWING POSITION AND DESCRIPTION OF WELDS OF FORGINGS, OR PARTICULARS OF TESTS APPLIED TO CASTINGS.

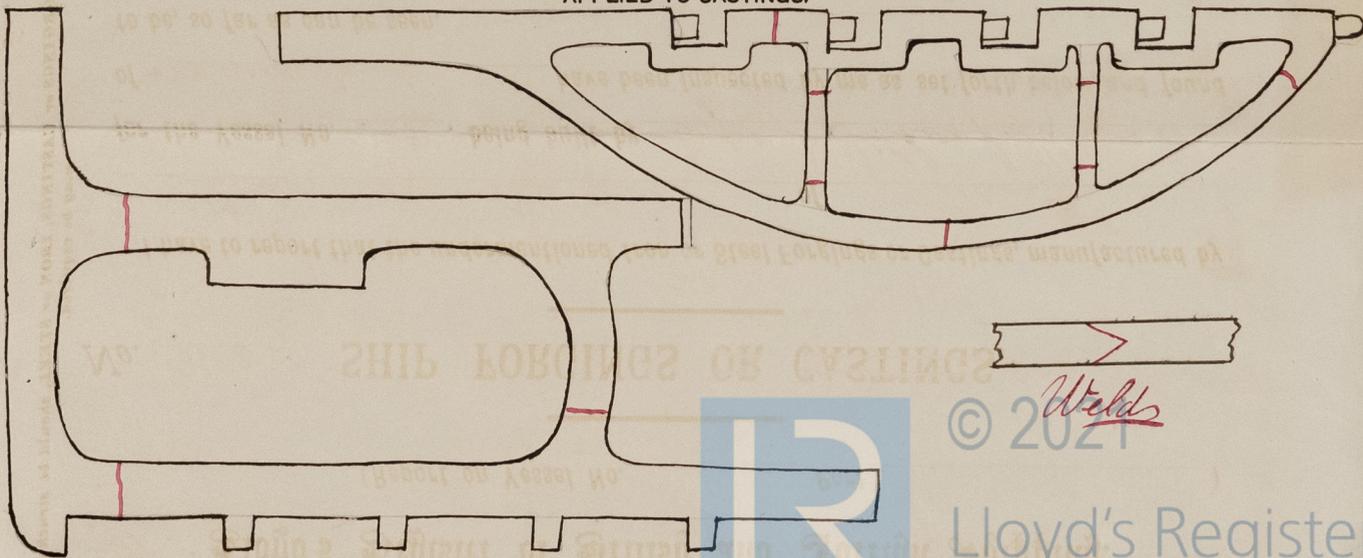

* If of Iron, state whether scrap or puddled iron.