
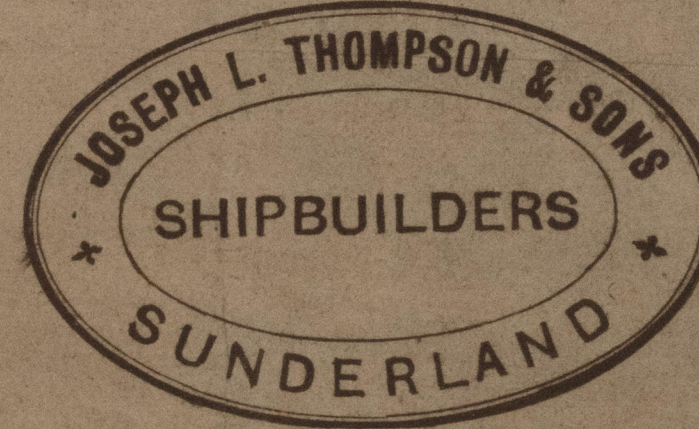


# SCREW STEAMER

Nº 232

27.10.87  
1.11.87  
15.12.87  
12.4.88




Ref: Sld. report No.

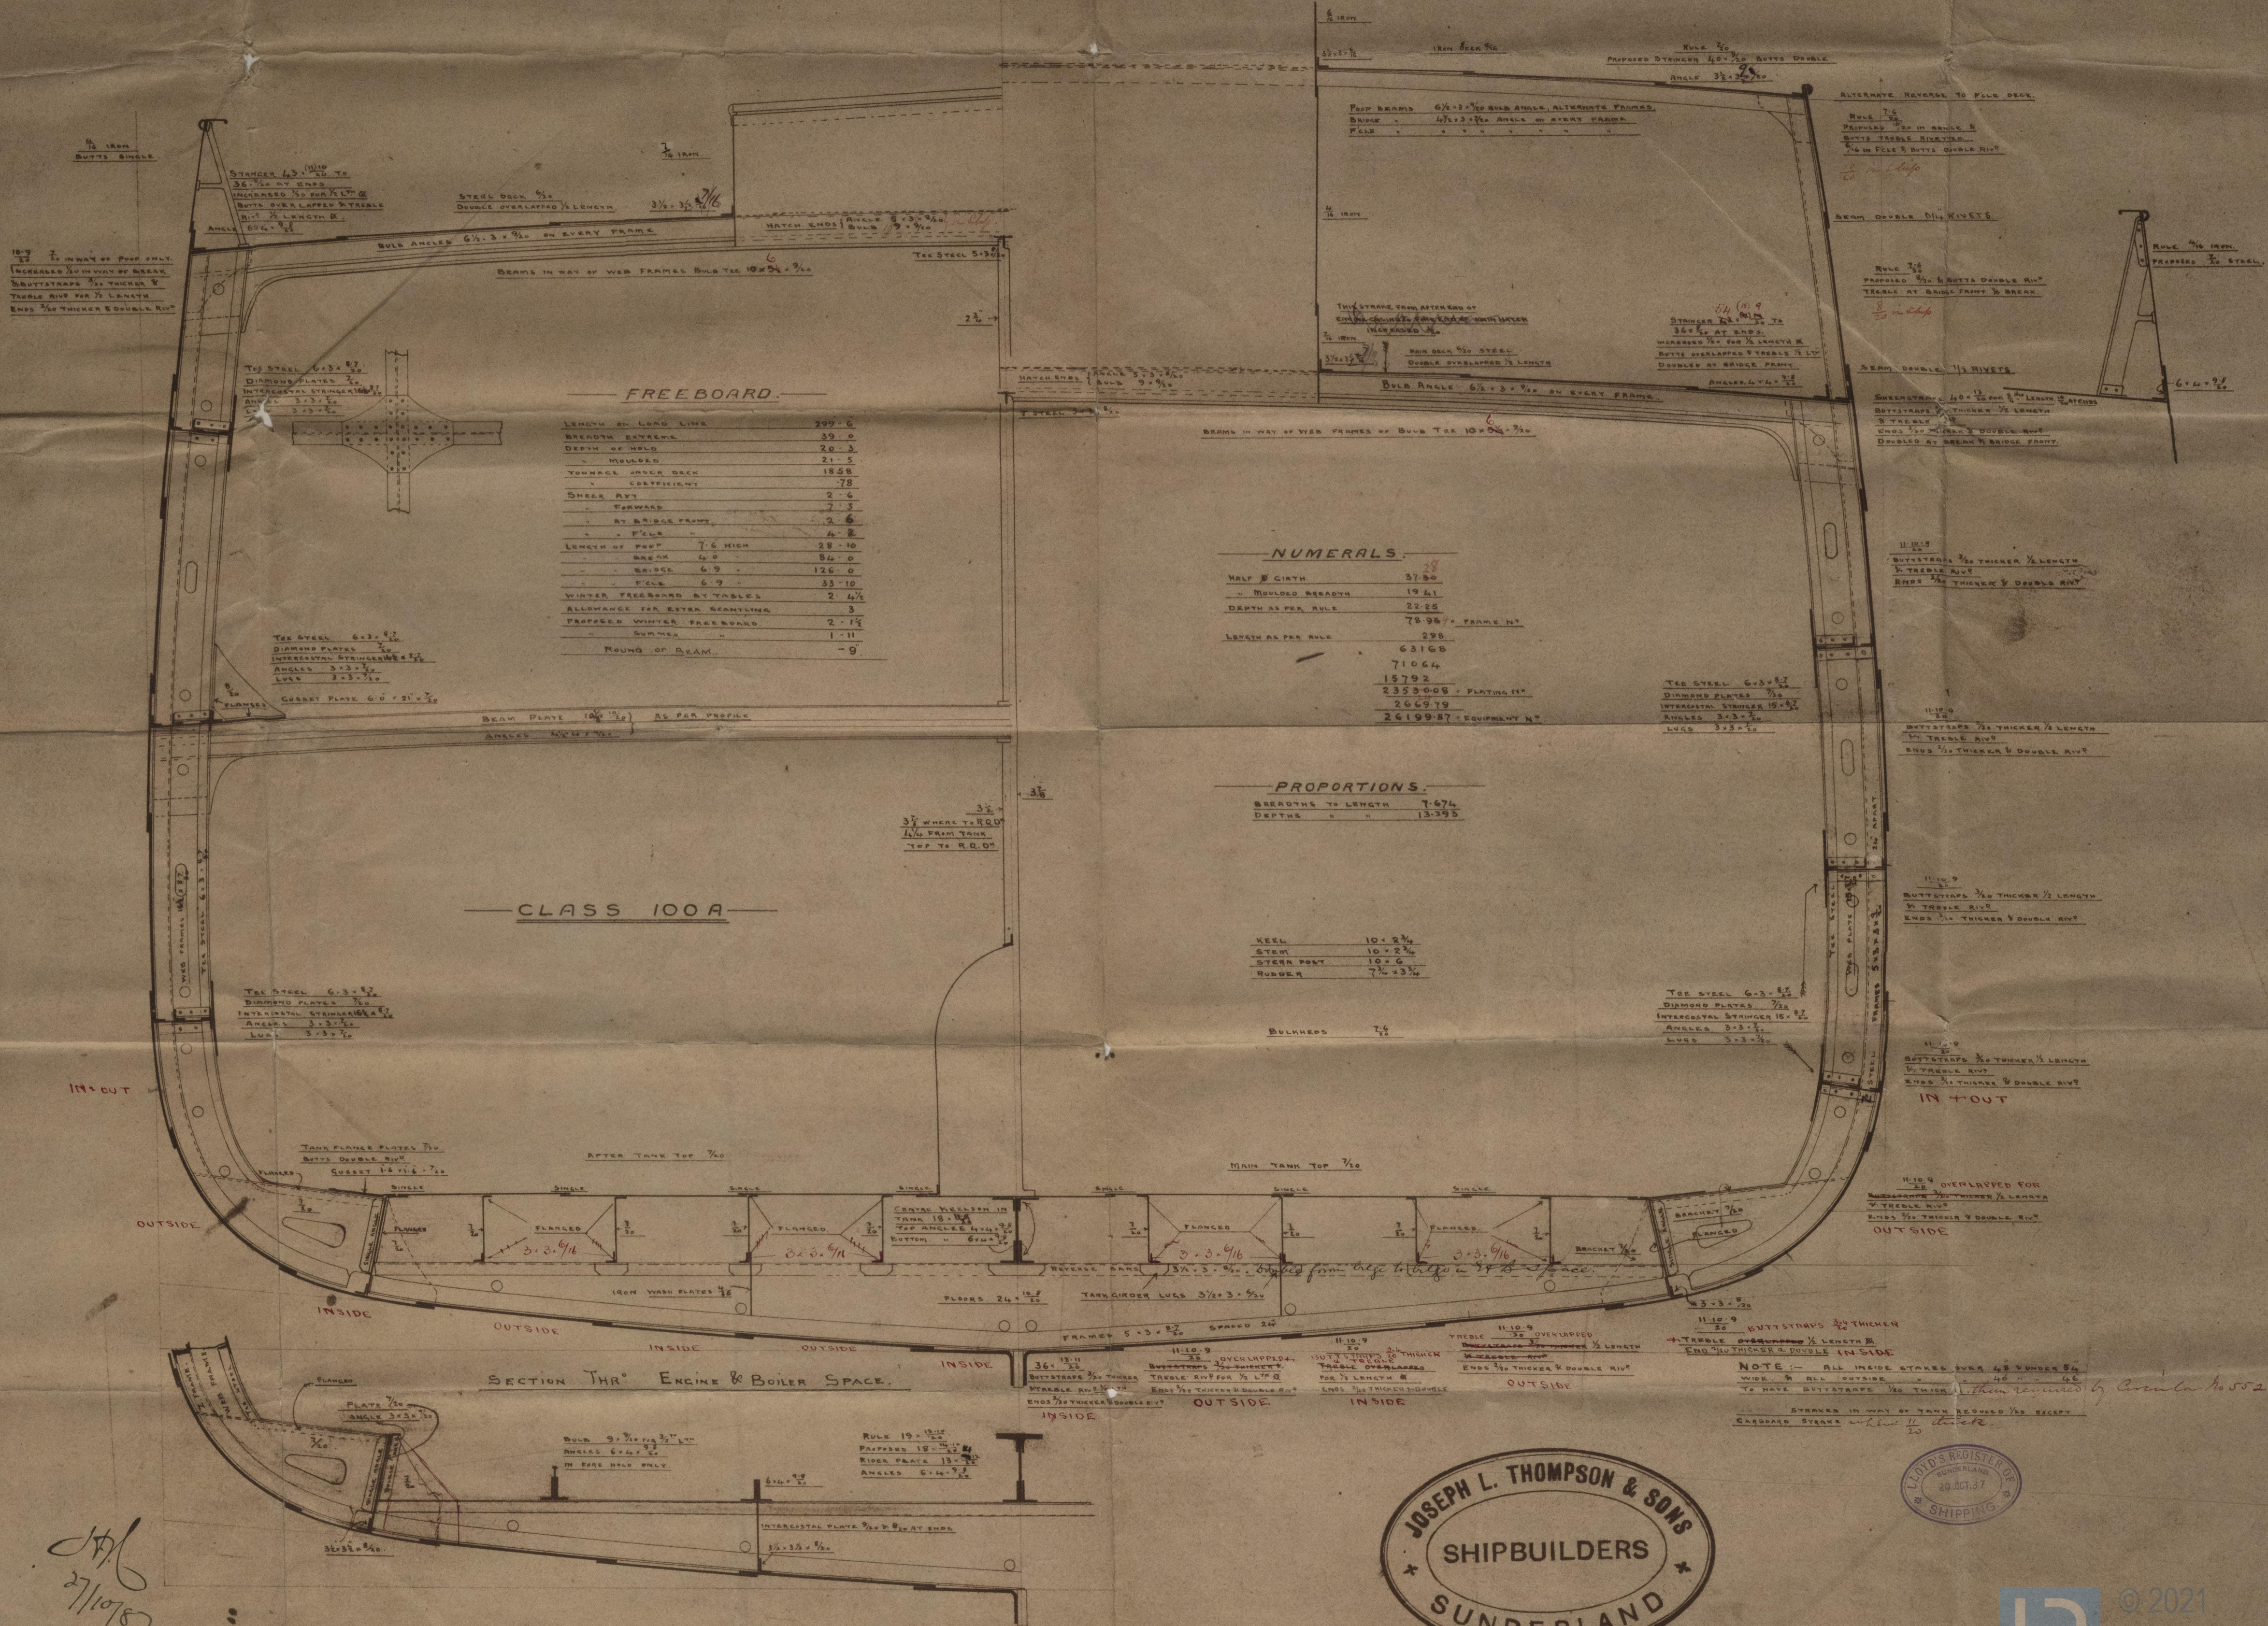








*Ind ships section*

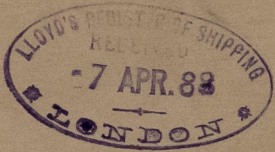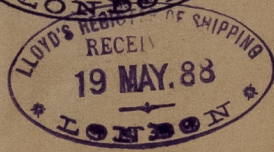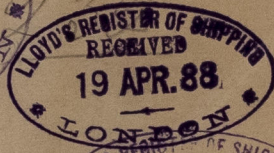

8410-ES6475

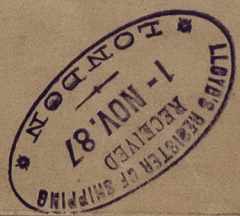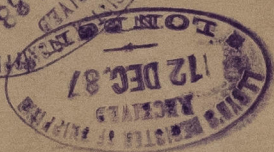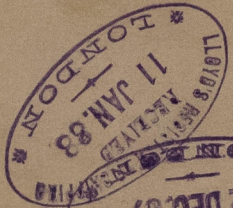

© 2021

Lloyd's Register Foundation