



See br. to
Sec: 2/3/88.

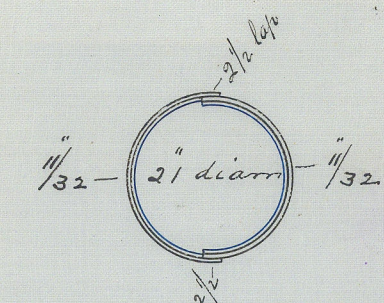


5/8" rivetting throughout

Foremast 40'-0" long

S.S. Kathleen/Std. report No. 14658

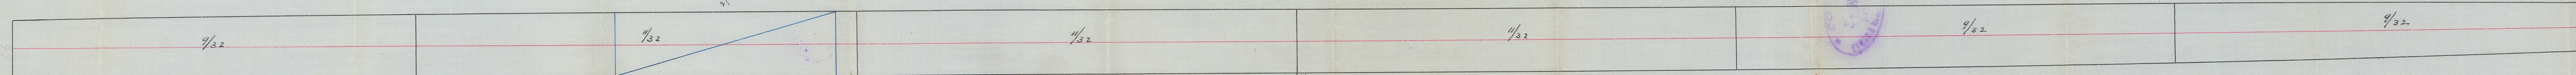


Doubled in way of Wedging

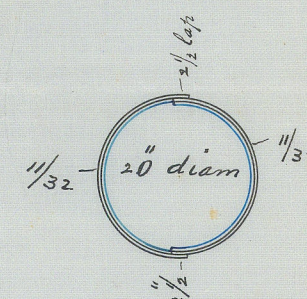

5/8" rivetting throughout.

Mainmast 63'-0" long.

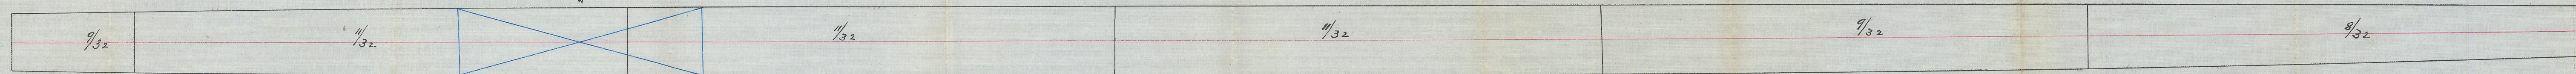

Doubled in way of Wedging.

Buttstraps to be rivetted and 1/16" thicker than plates they connect above deck.
Buttstraps double rivetted and 1/16" thicker than plates they connect below deck.


Scale 1/2" = one foot.

See letter
2/3/88



8400-858-0048

SLD958-0048

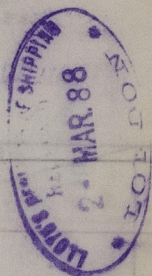

Doubled in way of wedging

1/8" rivetting throughout.

© 2021

Lloyd's Register
Foundation