


No. 23.

14.5.85.

ELEVATION

No. 75 S.S. **STEEL.**
Scale $\frac{1}{16}$ Inch to the Foot

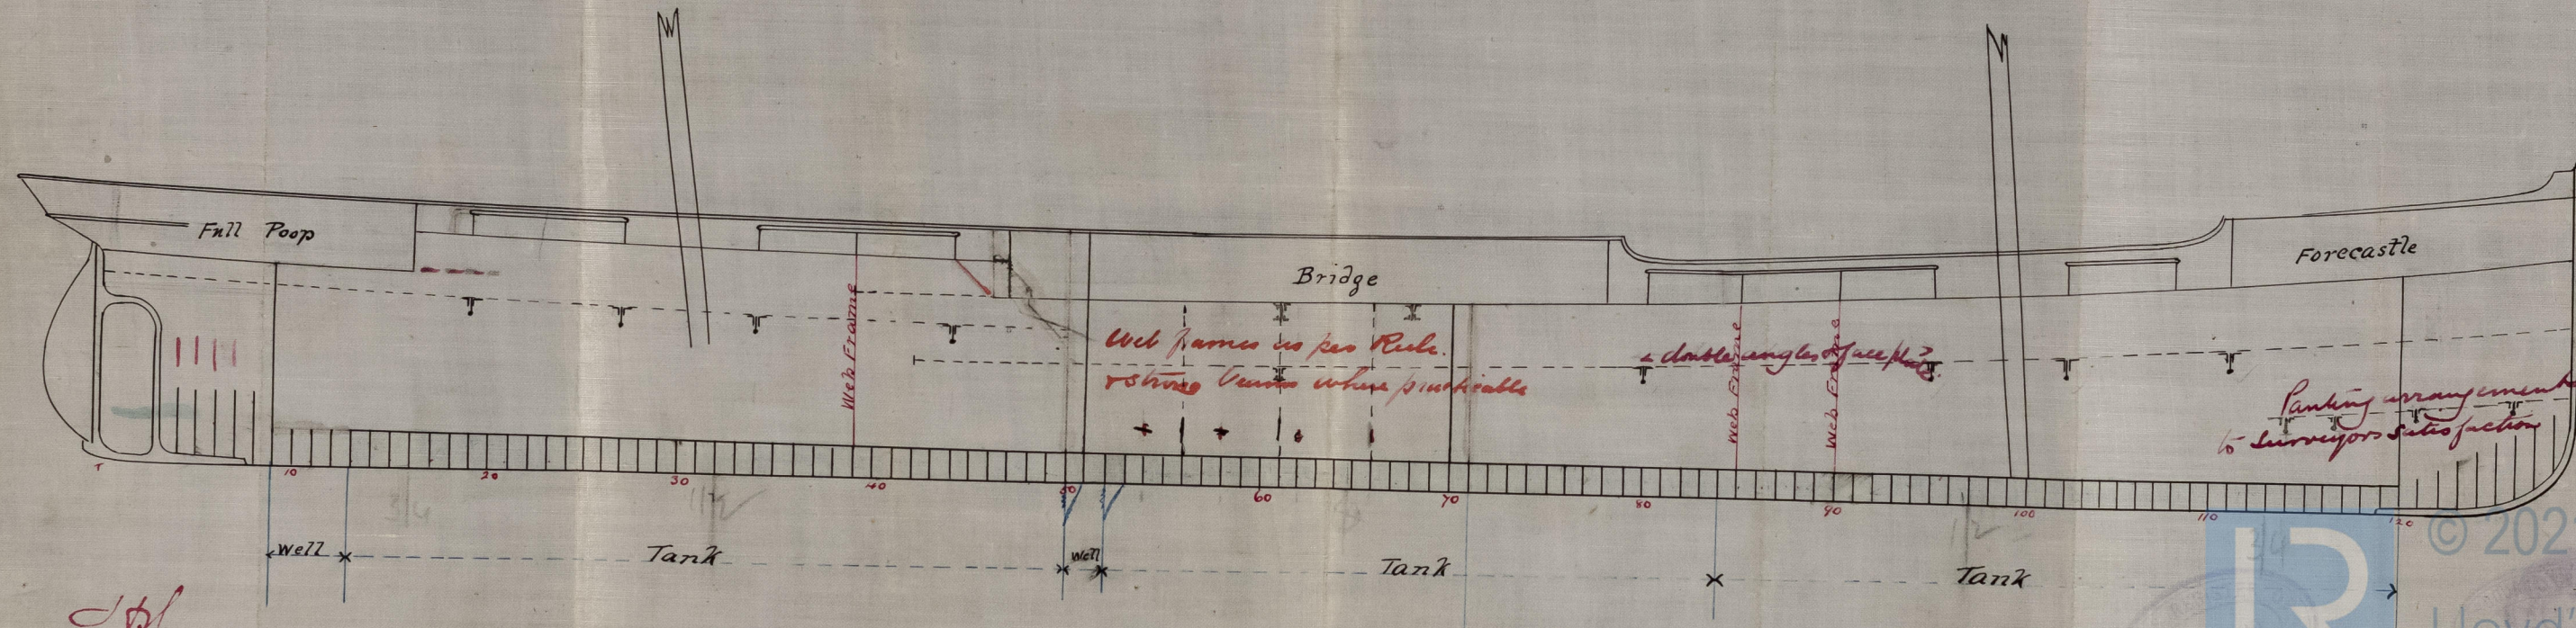

13/5/85




© 2021

Lloyd's Register
Foundation


SLD958-0049

SLD958-0049

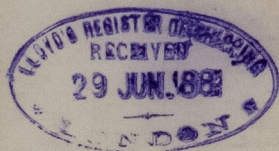

EVERY

734 No. 72
Rolle & the

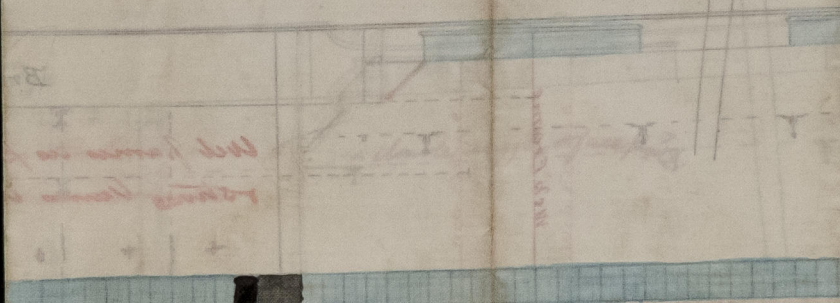

© 2021

Lloyd's Register
Foundation