


Graving 77 11 1/2



Ltr to Sld
19/12/85

Tank Suction Arrangement Plan. S.S. No 75. Kathleen Sld. report No 14658

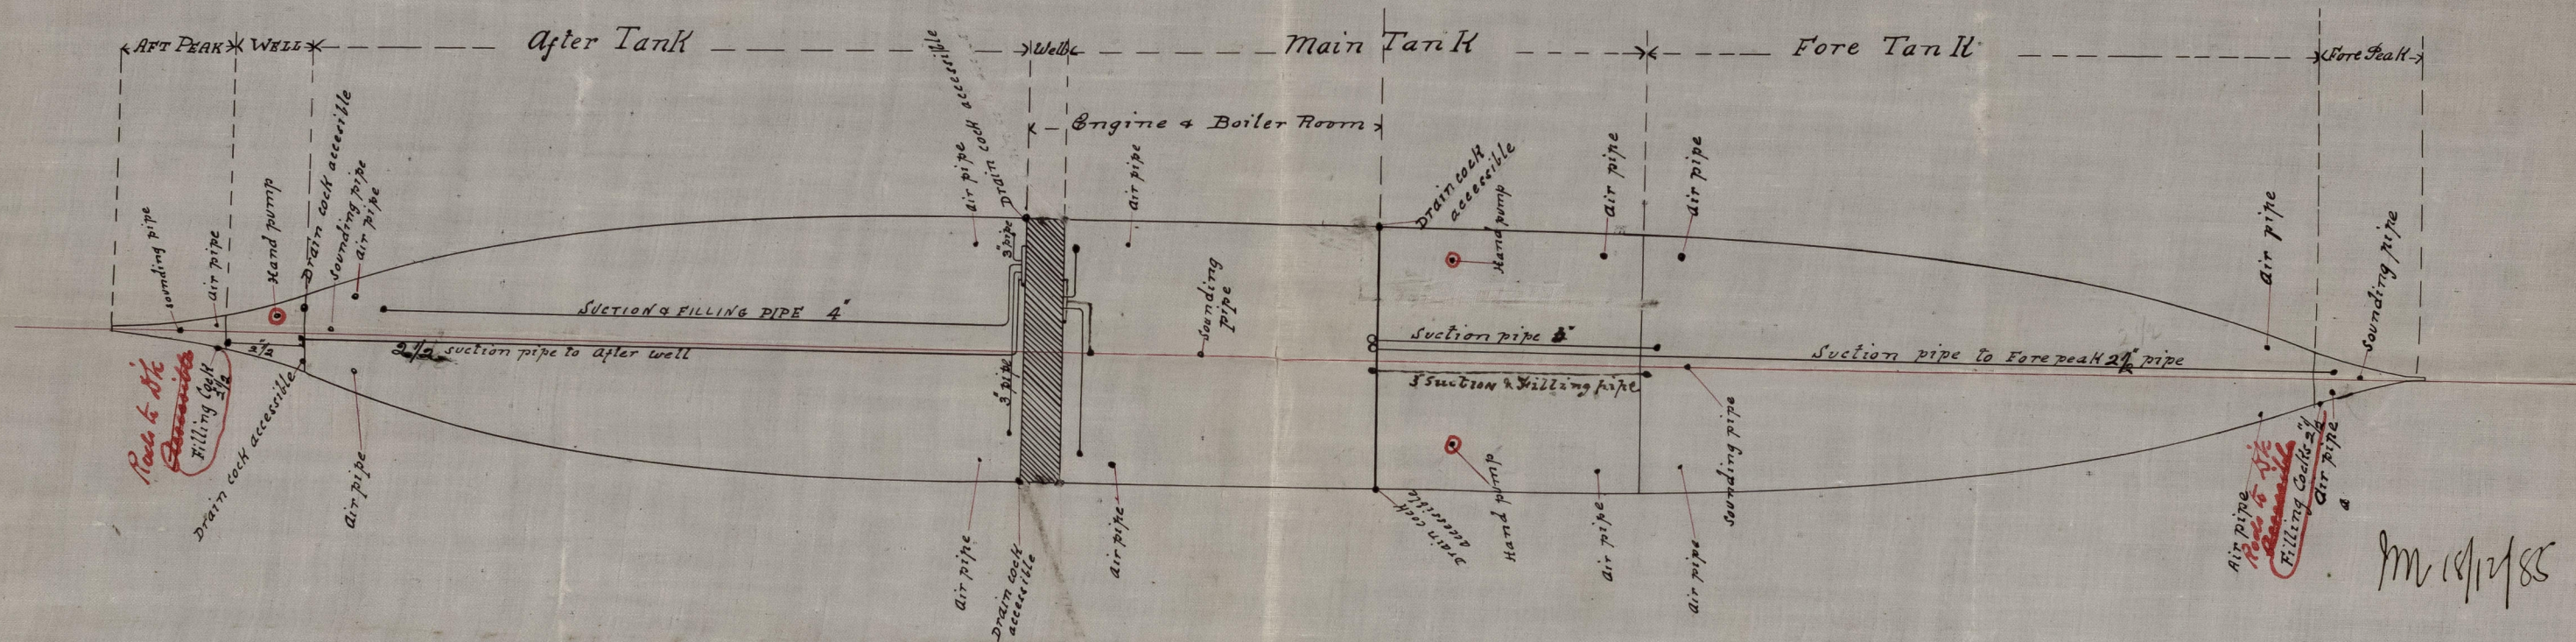

Air pipe
Rack to Sld
Filling Cock
Drain cock accessible

19/12/85



© 2021
15/12/85

Lloyd's Register
Foundation

SLD 958-0050