


G. G. NO 135

SCALE— $\frac{1}{8}$ INCH TO A FOOT



Is Beatrice Eld. report No. 14733

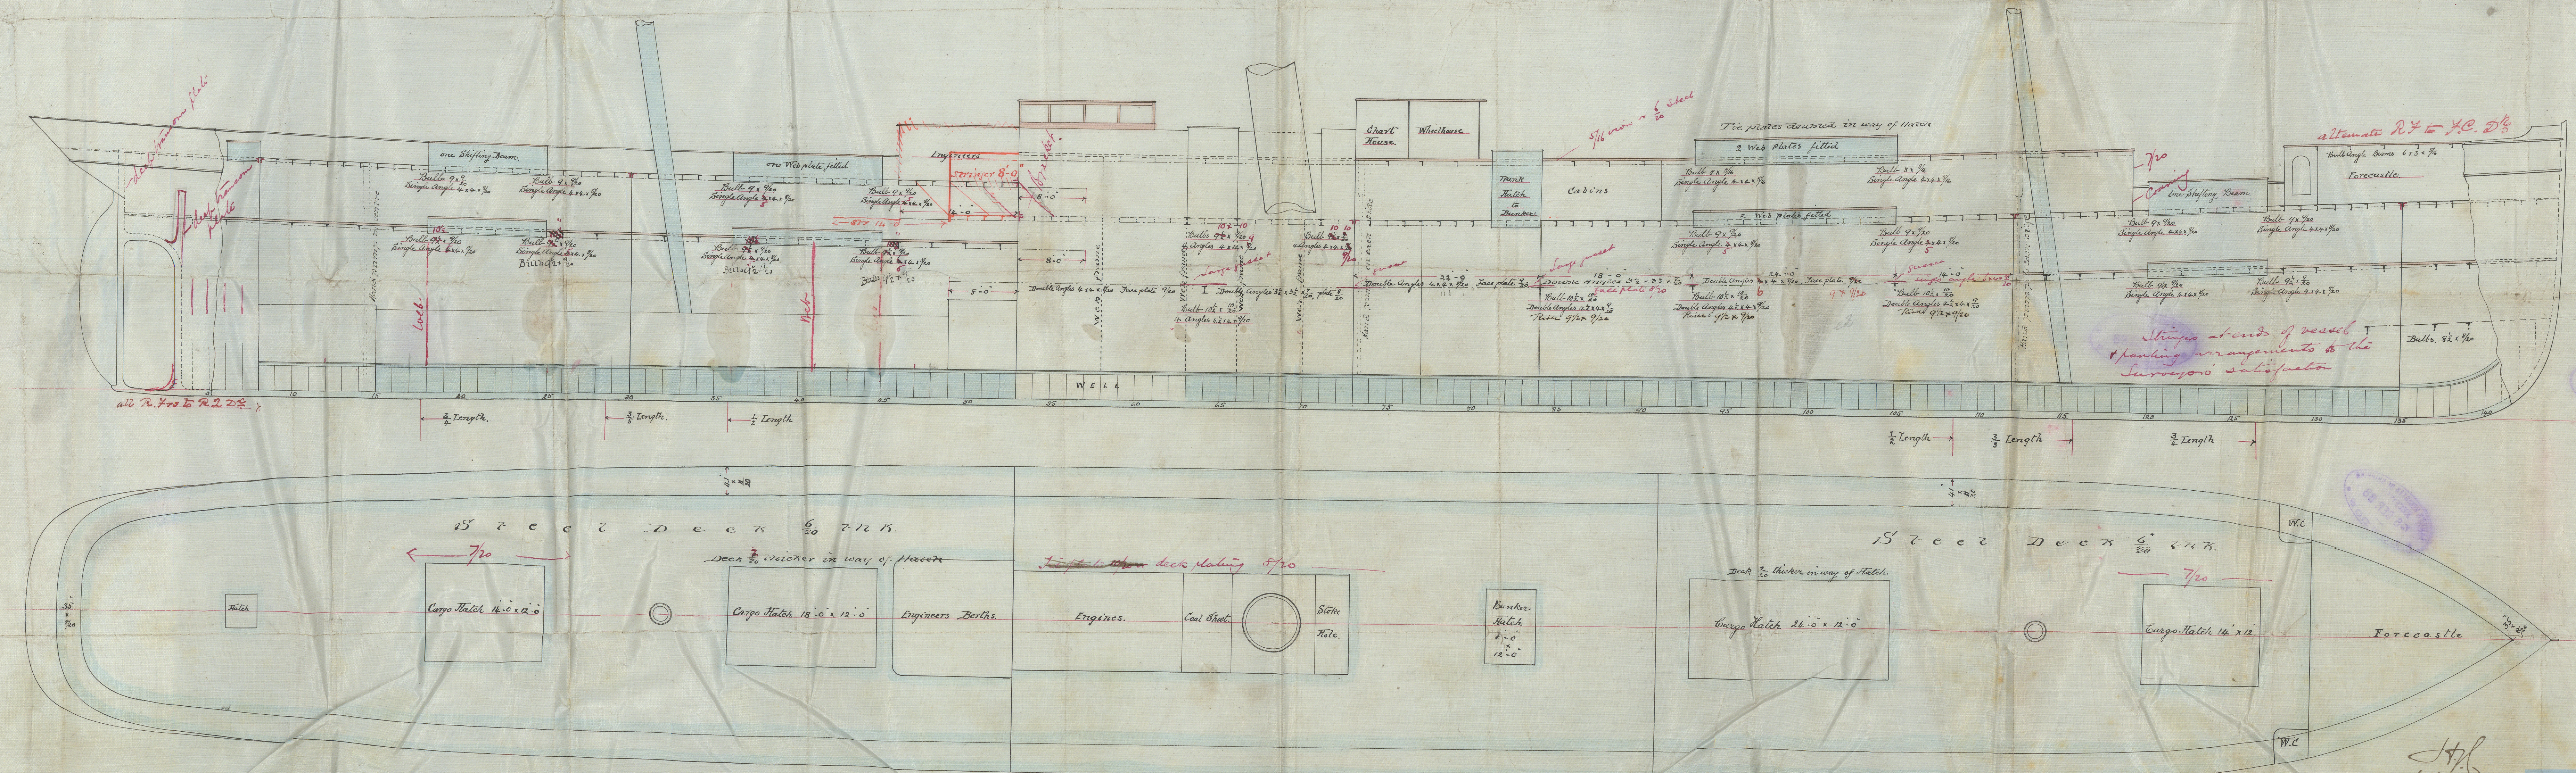

J. L.
107/1/88
24/1/88

SLD958-0308

EEHAI 704

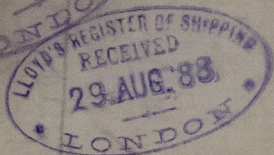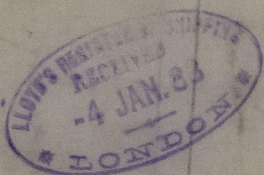

J. H. /
88/1/01
88/1/145



© 2021
Lloyd's Register
Foundation