

12.1.88
25.1.88

MIDSHIP SECTION

S.S. N9135

100A Grade

SCALE: 1/2 INCH TO A FOOT

J. Pearce/Id. report No. 144/33

plan of bridge side plating
X submitted 2/3/88

Stem plate 46 x 18
1/4 in. amidships to
ends, doubled for 20 ft
in way of fore end of bridge


11 10 x 9
20 20 x 20

only in After Hold
Angles 6 x 4 x 20
Built for 2 length
9 x 20

11 10 x 9
20 20 x 20

11 10 x 9
20 20 x 20

10/1/88
25/1/88

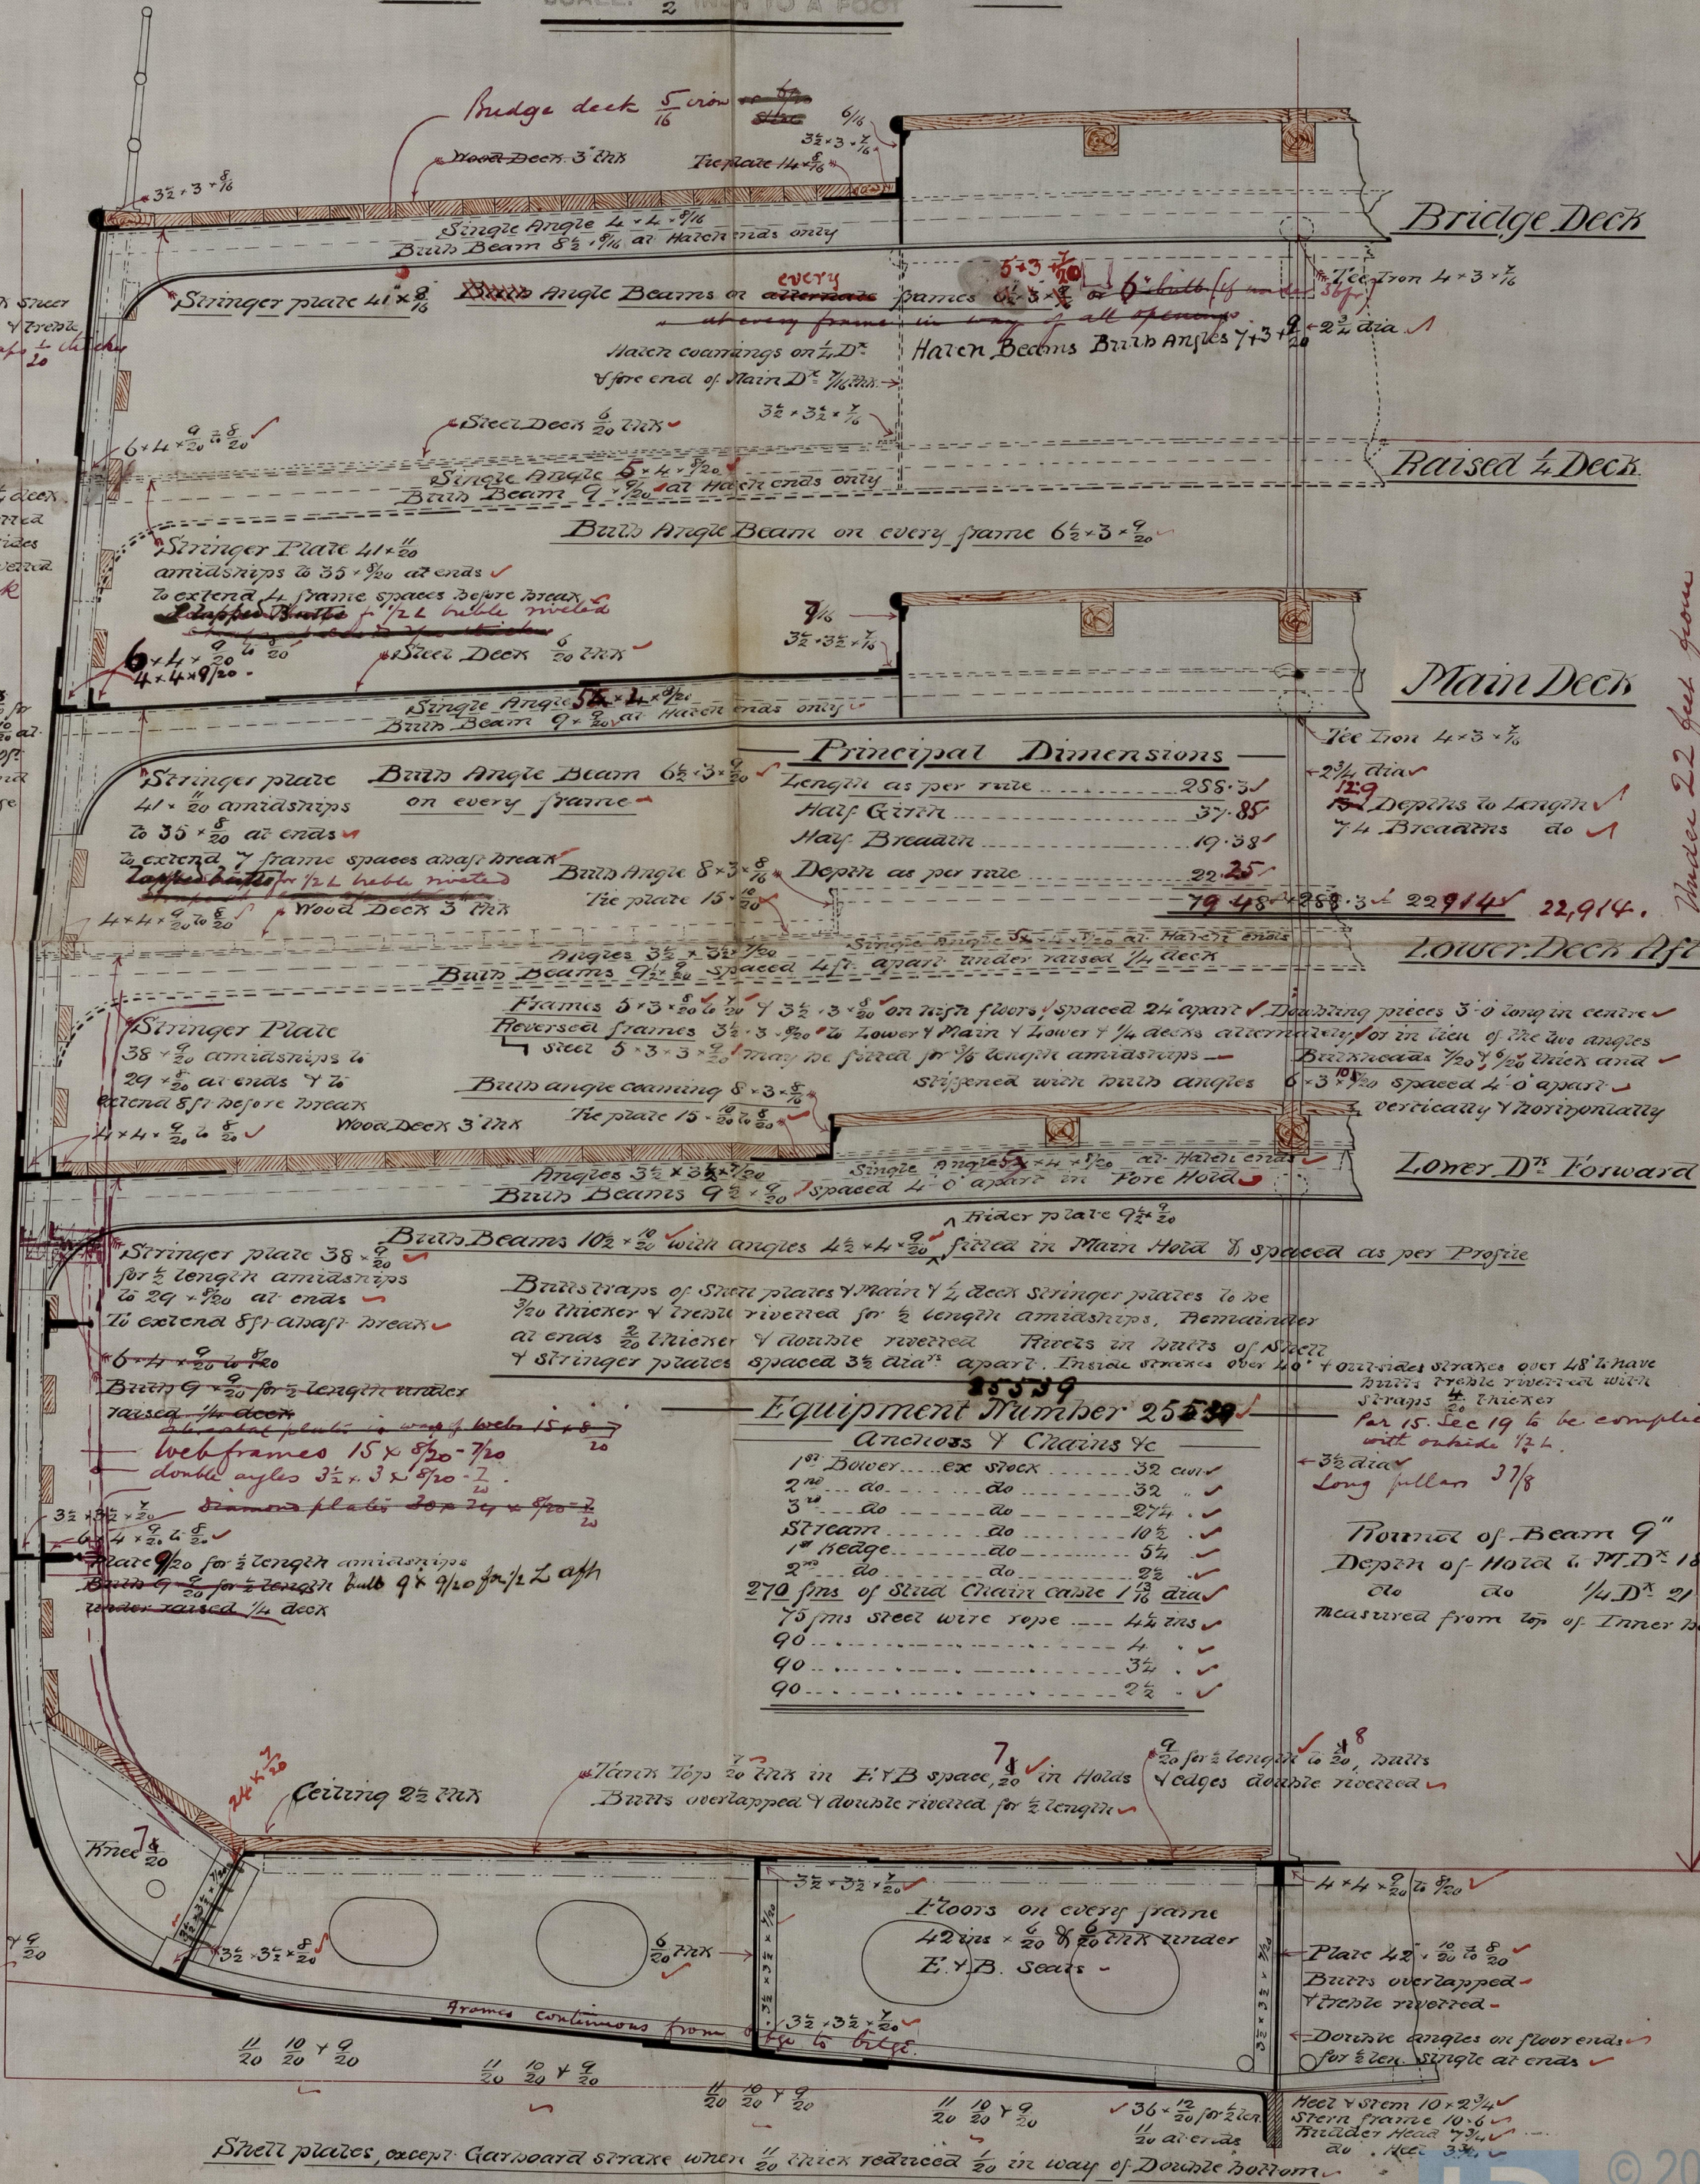

Under 22 feet from
top of keel to P. 2.914
21.914

Par 15. Sec 19 to be complied
with outside 12 ft.

Normal of Beam 9"
Depth of Hold 6 M.D. 18.6
do do 1/4 D. 21.112
measured from top of inner bottom

SLD958-0309

LLOYD'S REGISTER OF SHIPPING
RECEIVED
1-1-88
LONDON

LLOYD'S REGISTER OF SHIPPING
RECEIVED
29 AUG 88
LONDON

LLOYD'S REGISTER OF SHIPPING
RECEIVED
-4 JAN 83
LONDON

LLOYD'S REGISTER OF SHIPPING
RECEIVED
17 JAN 83
LONDON

32188
18.1.88

MIDSHIP

Long A

Discharge of cargo 14/1/83

LLOYD'S REGISTER OF SHIPPING
RECEIVED
-8 SEP 83

