


Plan of Pumping Arrangement.  
S. S. No. 135

265 83  
Ltr. 4/1/88  
BARTRAM, HASWELL & CO  
IRON SHIP BUILDERS,  
SOUTH DOCK,  
BUNDERLAND.

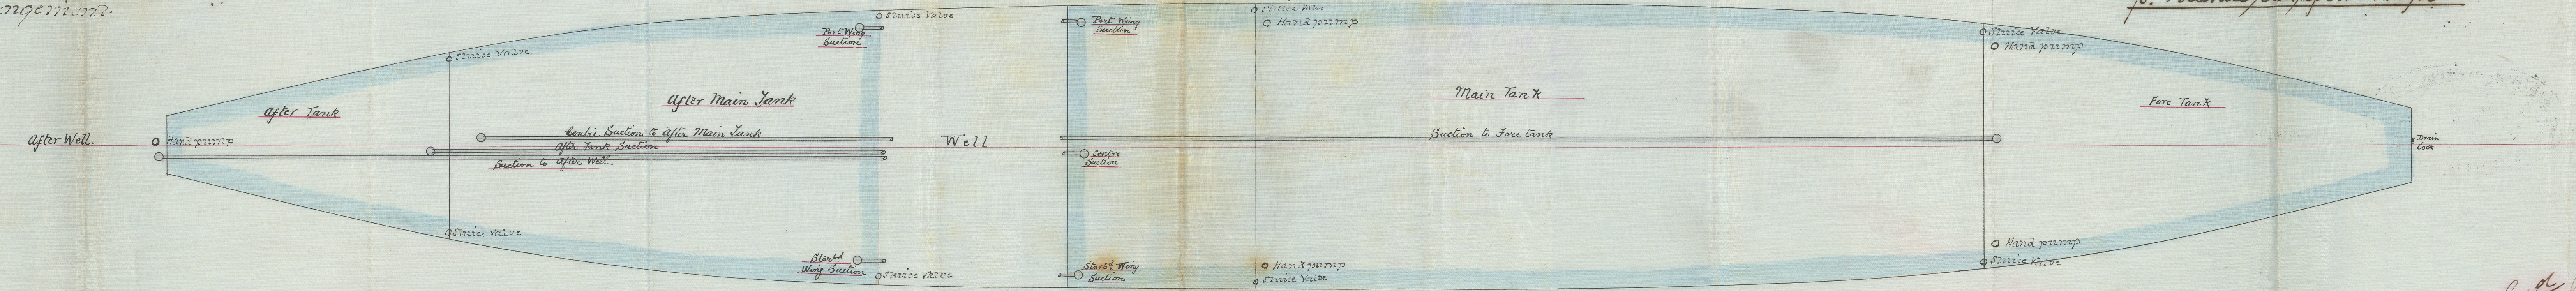



S. Peahice Id. report No. 14733

M  
4.1.87

Red Jan 3<sup>rd</sup> / 88  
JH  
WA

SLD958-0321



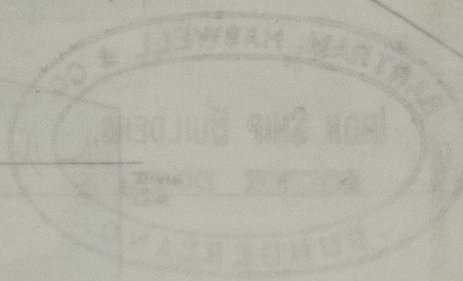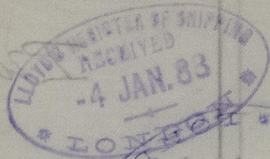

SLD958-0321



© 2021

Lloyd's Register  
Foundation