

Lloyd's Register of British and Foreign Shipping.

(Report on Vessel No. 14433 Port Sunderland)

Sund

No. 762a

SHIP FORGINGS OR CASTINGS.

I have to report that the undermentioned Iron or Steel Forgings or Castings, manufactured by

Mr Tho Ray

of Pallion

for the Vessel No. 135, being built by Ships Bartram Maswell & Co.

of Sunderland have been inspected by me as set forth below, and found

to be, so far as can be seen, sound.

The words FORGINGS or CASTINGS, IRON or STEEL, should be struck out as may be required.

Mark on Forgings.


Lloyd's
No. 762a
ob. Co.

Thos Cameron

Sunderland 20/7/88

	STERN FRAME.	RUDDER FRAME.	STEM.
Material*	<u>Scrap iron</u>	<u>Scrap iron</u>	<u>Scrap iron</u>
How made	<u>Fayed</u>	<u>Fayed</u>	<u>Fayed</u>
Dimensions	<u>10 x 6'</u>	<u>4 3/4 - 3 3/4</u>	<u>10 x 2 3/4</u>
Progress on Inspection	<u>Fayed Limited</u>	<u>Fayed Limited</u>	<u>Fayed.</u>
Dates when Inspected	<u>Feb 15-March 2-4-23-29</u> <u>April 11-18-28/88</u>	<u>May 5-10-16-18-29 June 7-9-16</u> <u>14-22-23-27-29 July 6/88</u>	<u>March 2/88</u>

SKETCHES OF FRAMES SHEWING POSITION AND DESCRIPTION OF WELDS OF FORGINGS, OR PARTICULARS OF TESTS APPLIED TO CASTINGS.

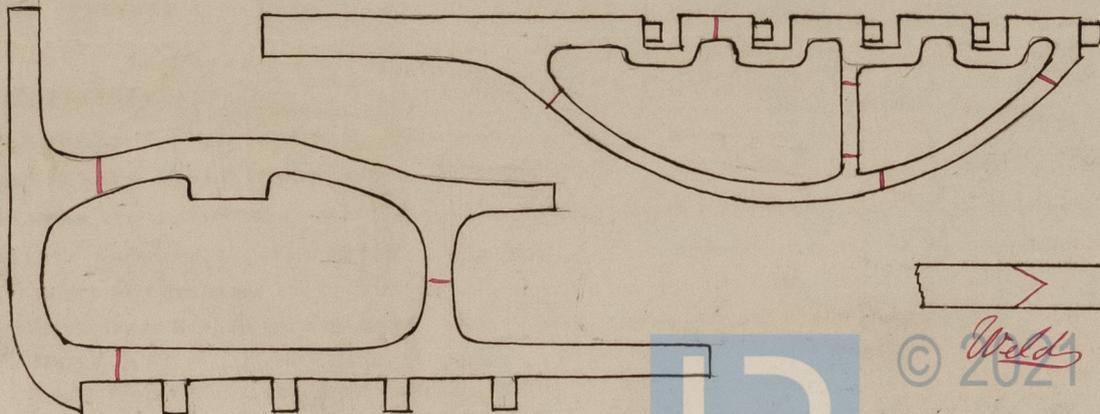

* If of Iron, state whether scrap or puddled Iron.



SLD958-0322