


of Reaice's report No. 14733.

Sketch of Iron Masts S. S. No 735

Scale $1\frac{1}{2} = 1$ foot




Fore Mast

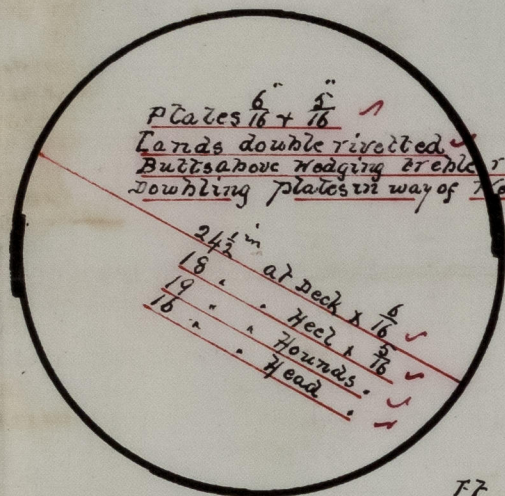

	FT. in
Deck to Hounds ———	41.0
Head ———	11.0
Housing ———	28.0
<u>Extreme Length ———</u>	<u>80.0</u>

Main Mast

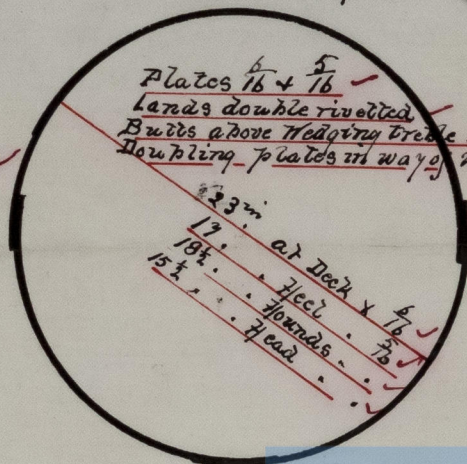

	FT. in
Deck to Hounds ———	46.0
Head ———	10.0
Housing ———	17.0
<u>Extreme Length ———</u>	<u>73.0</u>

SLD 958-0323

© 2021 Lloyd's Register Foundation